


65-9934
15897

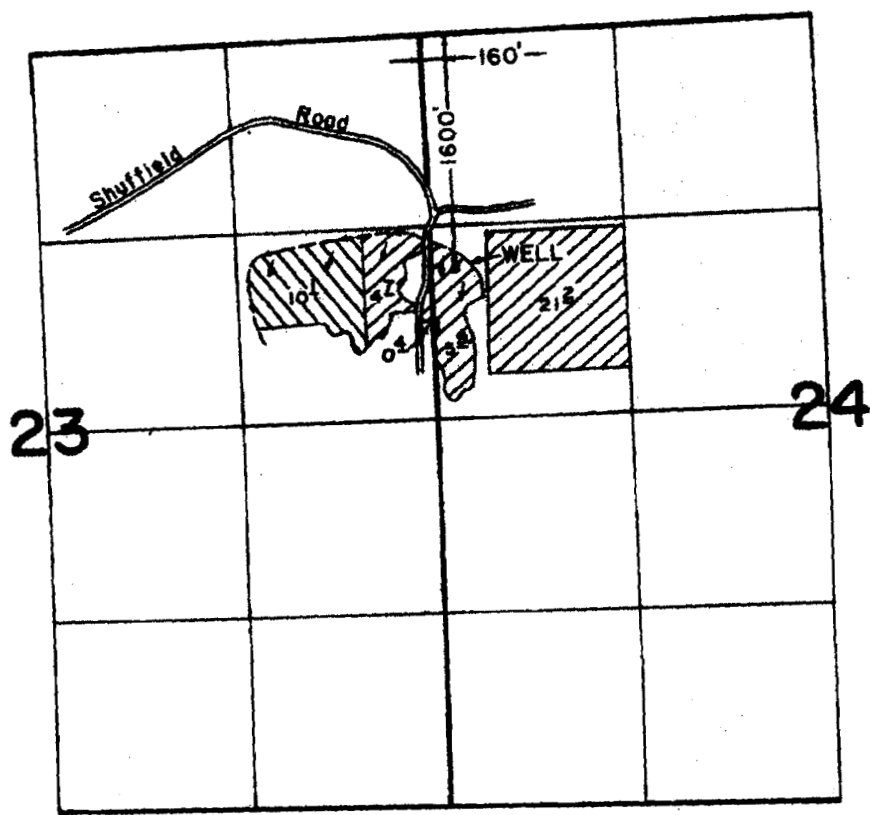

T. 29 S., R. 17 E., W.M.



SCALE: 1" = 1320'

FINAL PROOF SURVEY
UNDER

G-5719

G-5521



Application No. G-10832 Permit No. G-9934



IN NAME OF

ERNEST F. & MARY E. SHUFFIELD

Surveyed JULY 19 1989, by B.W. BISHOP