


T. 26S., R. 6W., W.M.

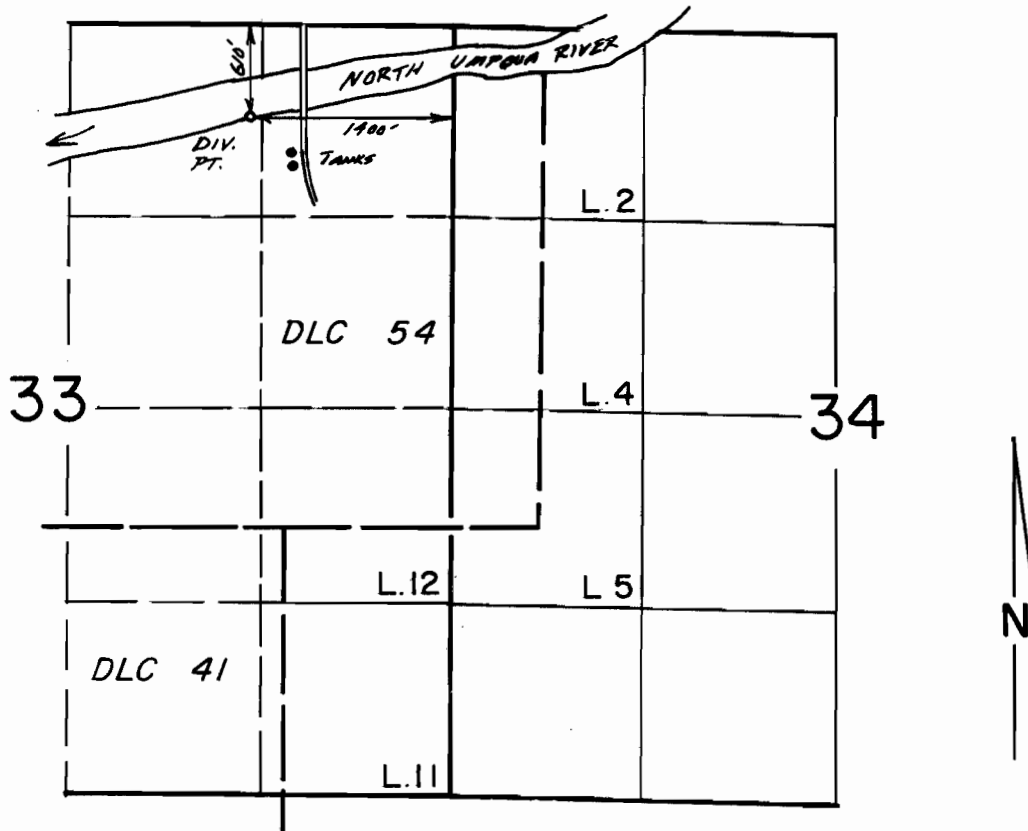

Scale 1" = 1320'

FINAL PROOF SURVEY
UNDER

42167 31555
Application No. ~~48168~~ Permit No. ~~36186~~....
IN NAME OF

UMPQUA BASIN WATER ASSOC., INC.

Surveyed Nov. 30, 1993, by B.S. James.....