


T.2S. R.1W., W.M.

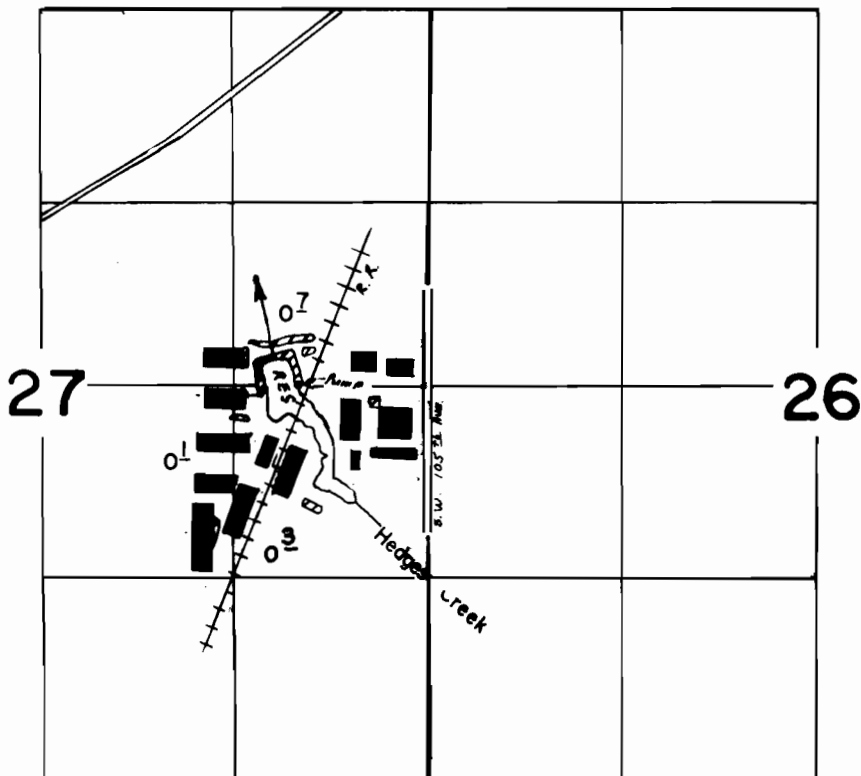

DAM LOC: 200 FT N, 970 FT W. FROM E $\frac{1}{4}$ CORNER OF SECTION 27.

Scale: 1" = 1320'

 = Buildings w/ Fire Suppression system

FINAL PROOF SURVEY UNDER

R-45326 R-5251
Application No. ...45327... Permit No. ...33229...
IN NAME OF

TRI-COUNTY INDUSTRIAL PARK, INC.

Surveyed MAY 12, 1975, by R.G. MUCKEN.....
AUG, 2 1985 T.M. WARREN