


T.30S., R.5W., W.M.

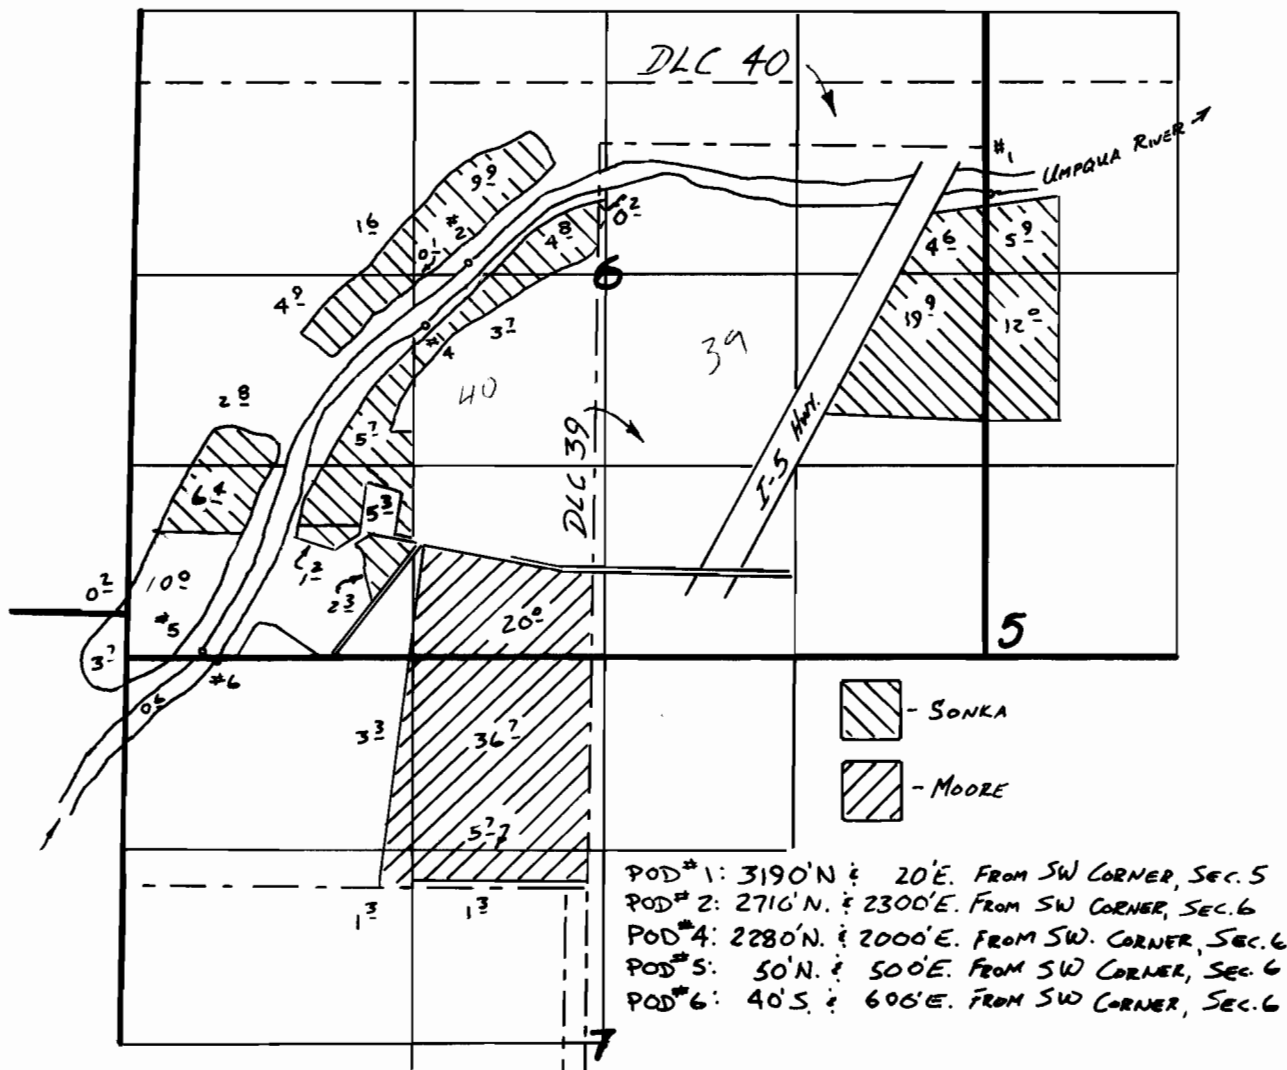

Scale 1" = 1320'

FINAL PROOF SURVEY UNDER

Application No. 57359 Permit No. 43353....
IN NAME OF

RONALD A. MOORE & JOSEPH L. & EVELYN SONKA

JULY 20 & 23, 1987 J. M. SCHMORDE

Surveyed May 30... 1984., by L. E. CASHION.....