


T. 4S., R. 5W., W. M.

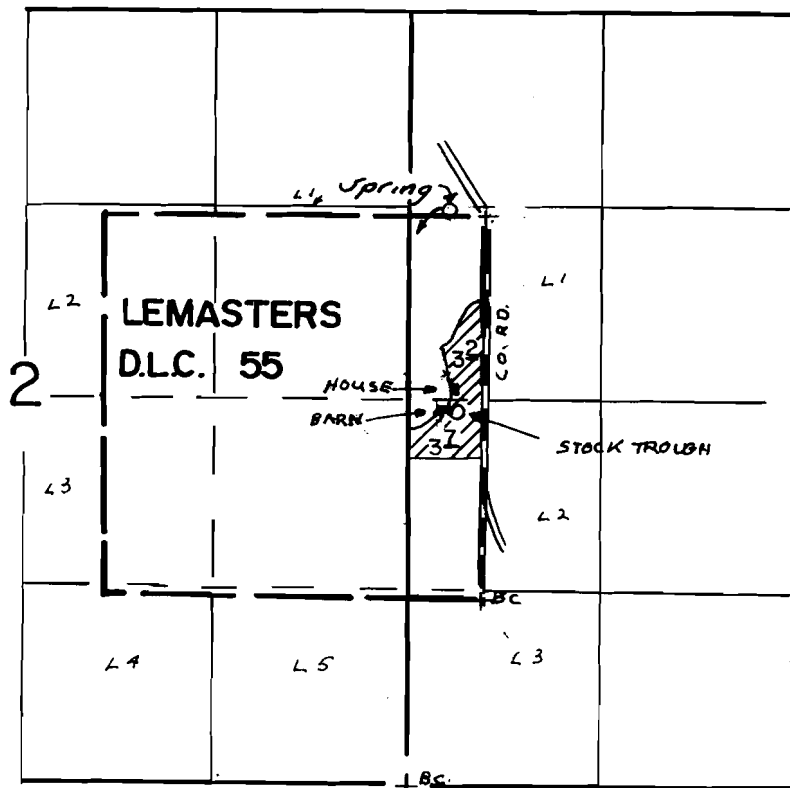

SPRING LOCATED: 30' N & 240' W FROM N.E. COR. D.L.C. 55

SCALE: 1"=1320'

FINAL PROOF SURVEY UNDER

Application No. 60286... Permit No. 45097.....

IN NAME OF
CLYDE & JACQUELINE REED
.....**CAMILLE C. THOMPSON**.....

Surveyed OCT. 6... 1983., by P. PAGTER.....