


RECEIVED

SEP 9 1997

WATER RESOURCES DEPT  
SALE OF OREGON

SECTION 16

T.8S.R.10W.W.M.

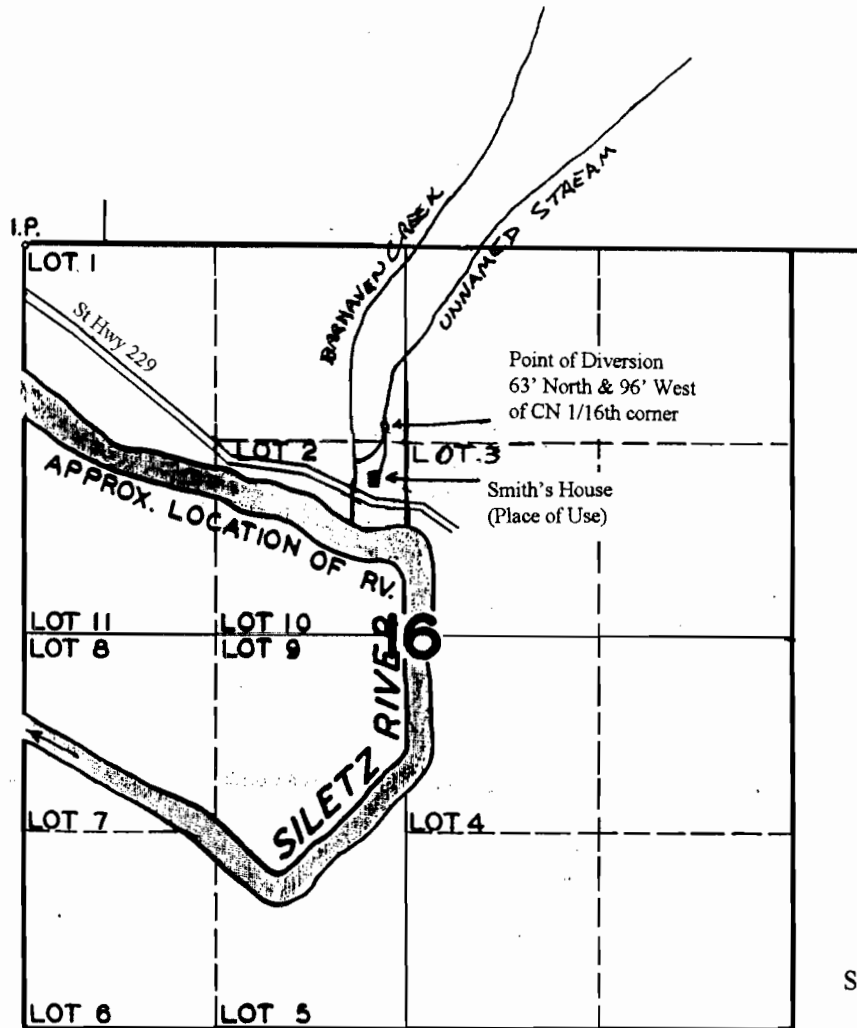


FINAL PROOF SURVEY

under

Appl. No. S-80565, Per. No. 52729

February 13, 1997

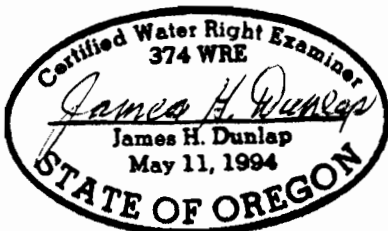

THIS MAP WAS PREPARED FOR THE PURPOSE OF IDENTIFYING THE LOCATION OF A WATER RIGHT ONLY AND IS NOT INTENDED TO PROVIDE LEGAL DIMENSIONS OR LOCATION OF PROPERTY OWNERSHIP LINES.