


Tax Lot No. TL1300 23 12 4D
Section 4 Township 23S Range 12W W.M.
Coos County

RECEIVED


SEP 30 1997

WATER RESOURCES DEPT.
STATE OF OREGON

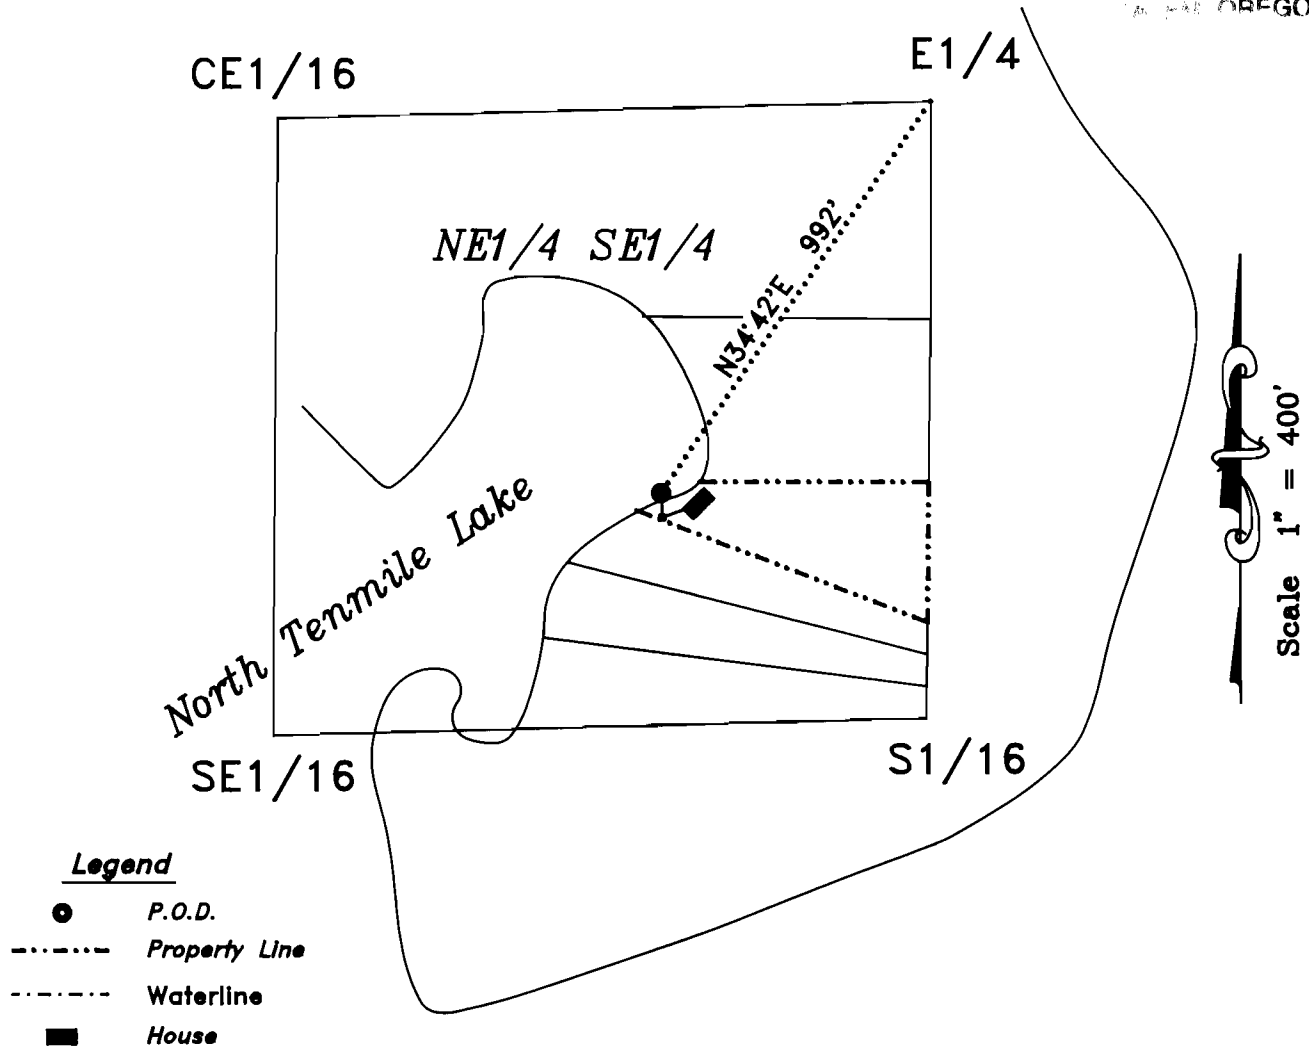

EXAMINERS DISCLAIMER STATEMENT

The preparation of this map was for the purpose of identifying the location of the Water Right only and has no intent to provide dimensions or location of property ownership lines.

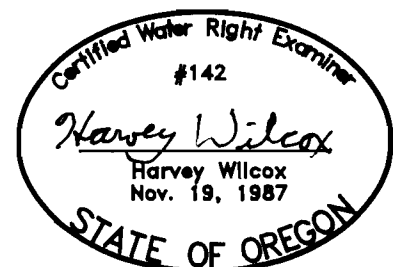

RENEWAL 6/30/98

FINAL PROOF SURVEY
IN THE NAME OF

Curtis G. and Wanda N. Ferren

Surveyed on 8/7/97 by H.A. Wilcox

Application No. S-81164
Permit No. 53086