



# T.6S., R.1W., W.M.

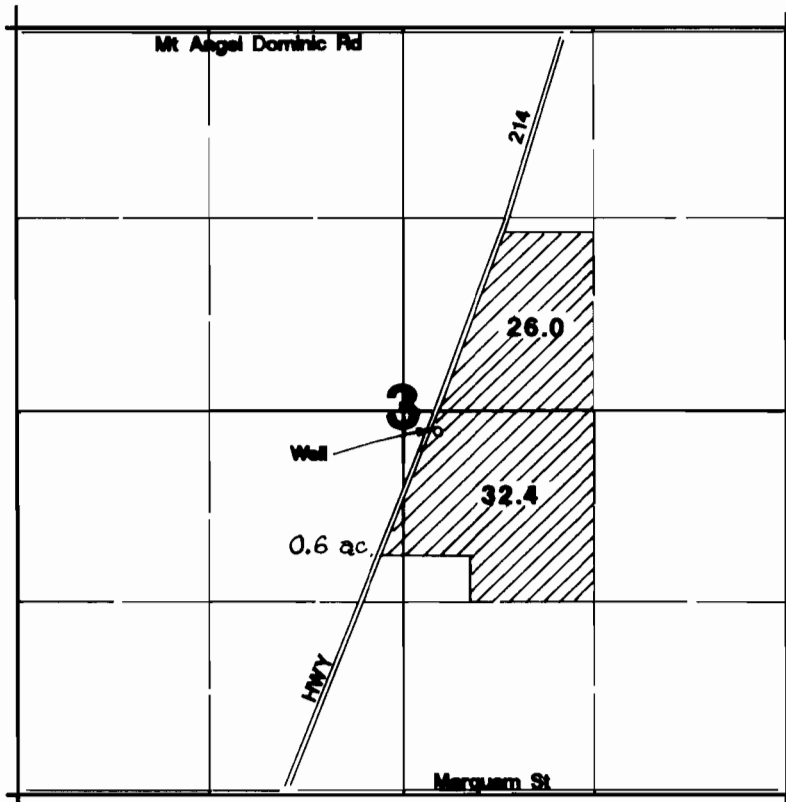


1" = 1320'

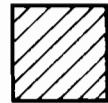

Area Irrigated

Well located 2500'N & 2390'W from SE corner Section 3.

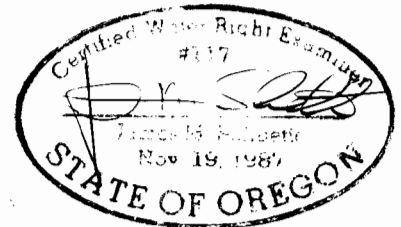

## Final Proof Survey

Application #: G-12167 Permit #: G-11108

In Name Of

### Thomas E. Smith

Surveyed on June 16, 1994 by JM Schuette