


G-5521
G-9934
T8003
75912



T. 29 S., R. 17 E., W.M.

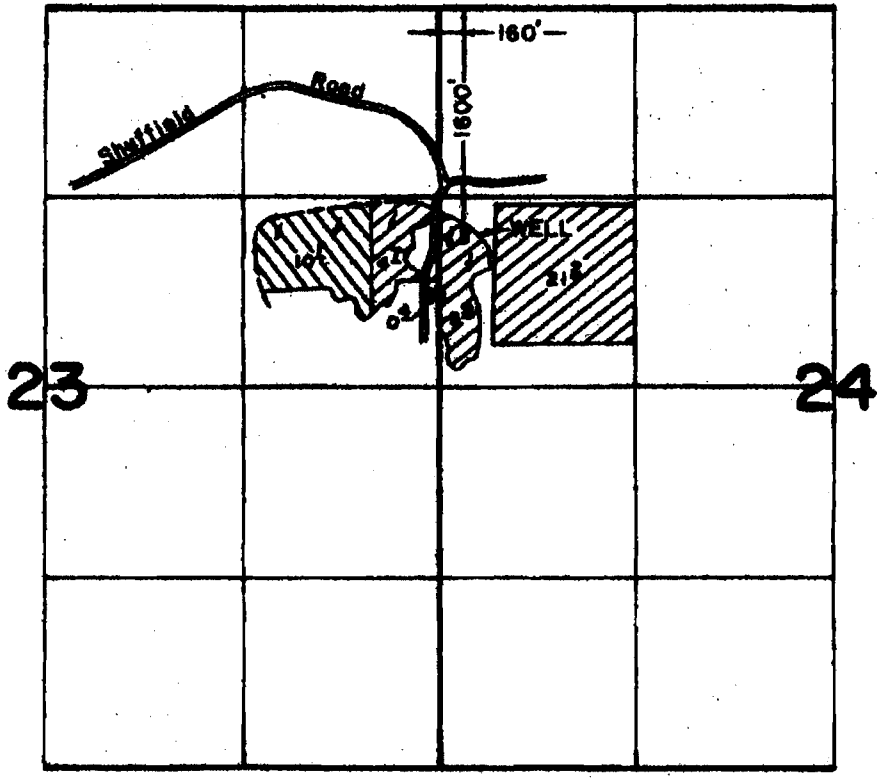

SCALE: 1" = 1320'

FINAL PROOF SURVEY UNDER

G-5719

G-5521

Application No. G-10832 Permit No. G-9934....

IN NAME OF

ERNEST F. & MARY E. SHUFFIELD

Surveyed JULY 19, 1989, by B.W. BISHOP...

2-28-90
41037-379-188A

94