


G-10026

75913
54251

T. 26S., R. 19E., W.M.

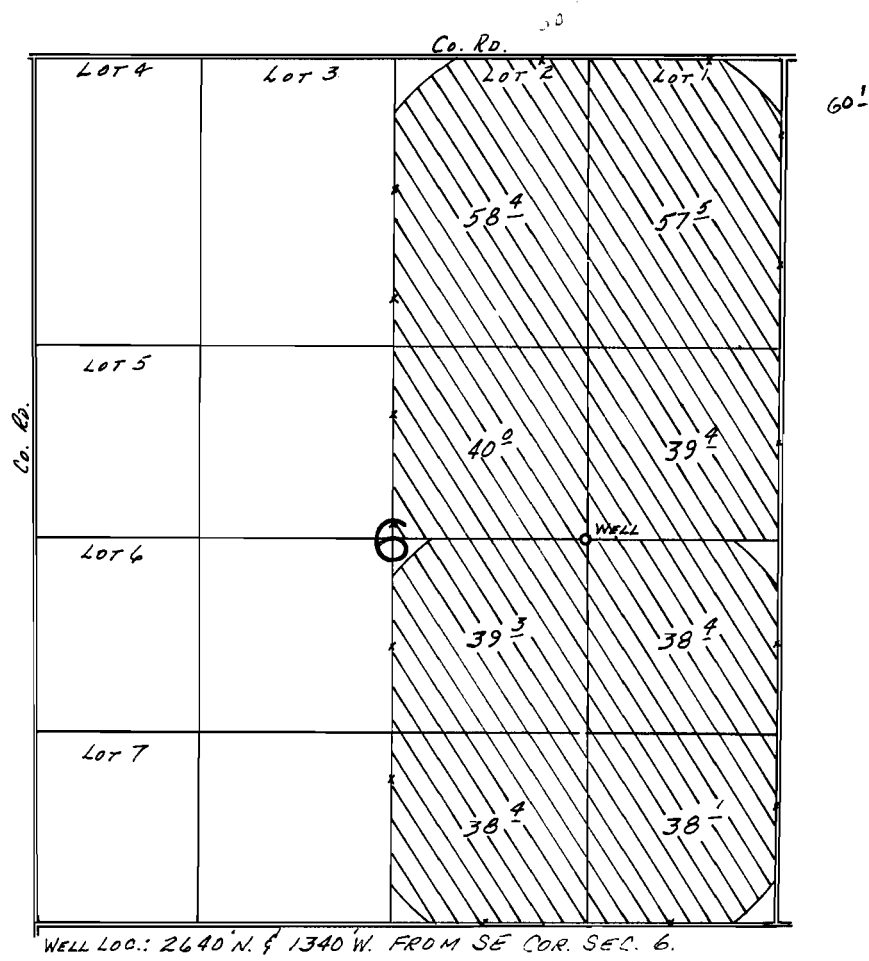

FINAL PROOF SURVEY UNDER

Application No. G-10870 Permit No. G-10026...
IN NAME OF

GARY L. PERKINS

Surveyed Sept. 16, 1985, by B.W. BISHOP