


T. 26S., R. 19E., W.M.

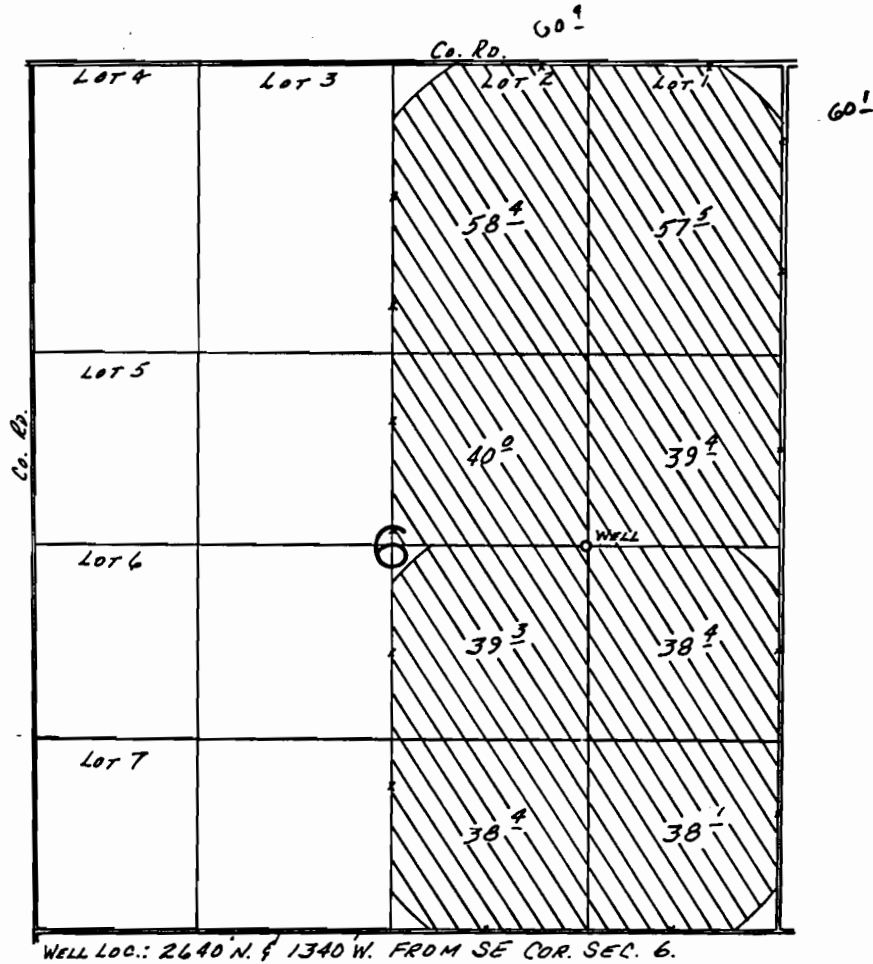

SCALE: 1" = 1320'

Application No. G-11490
 Permit No. G10743