


— MAP —

Accompanying application of Jno. B. Rader, of Eagle Point, Jackson County, Oregon, for permit to the water from a spring, tributary to Antelope Creek, Jackson County, Oregon, for Stock Purposes.

— August, 1926. —

T.35. S. R. I. W. W. M.

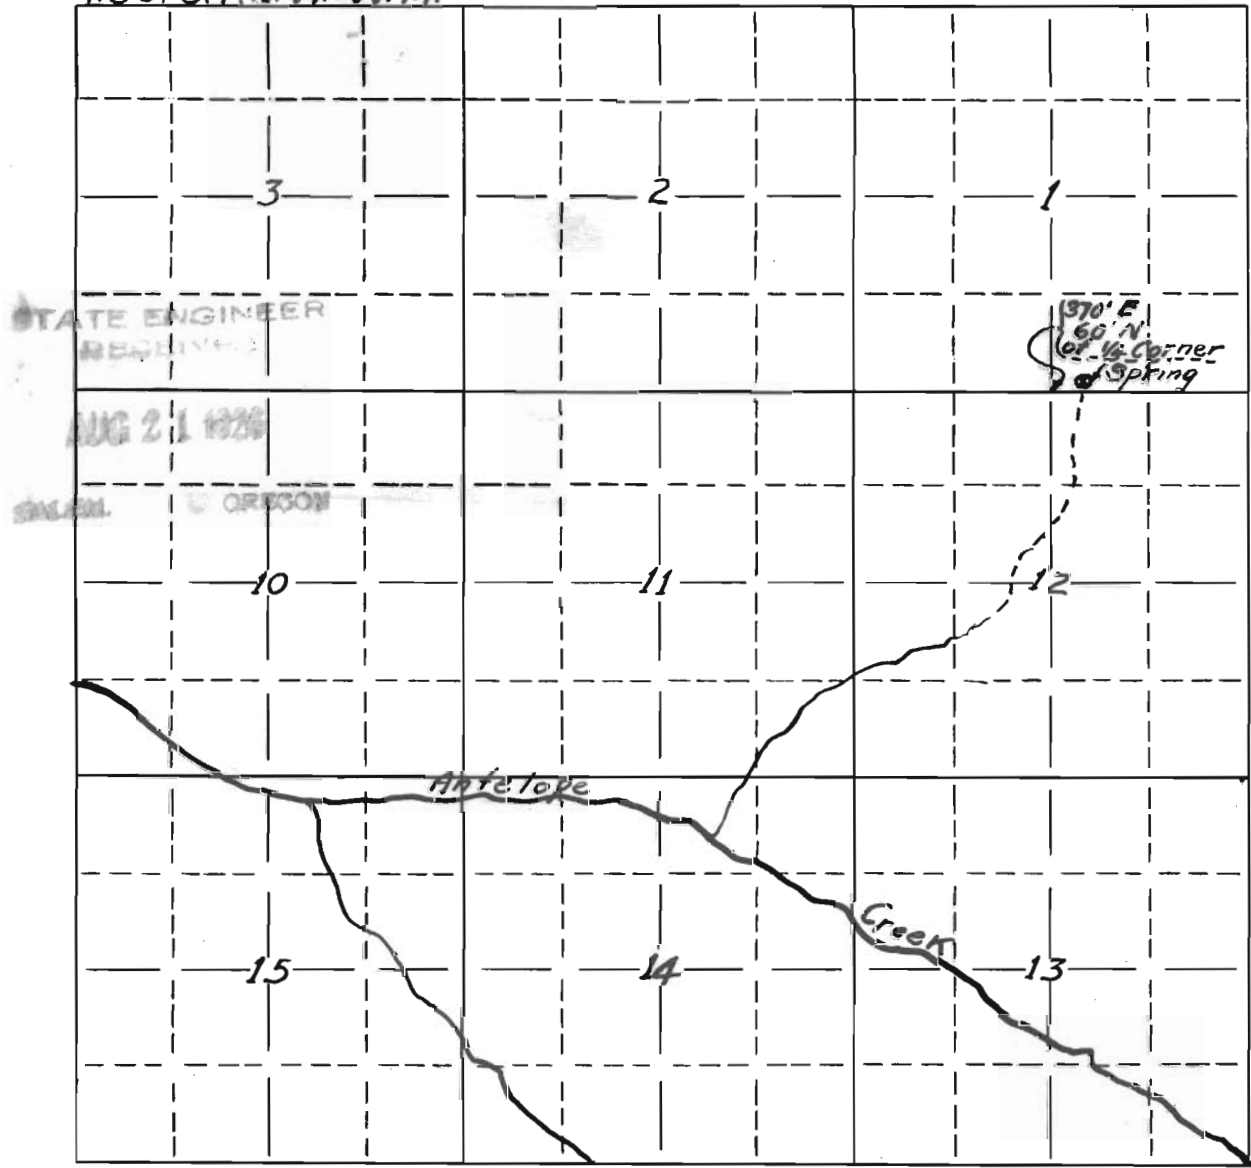

Map made from plot and notes furnished by J. B. Rader, the same, correctly showing location of spring, together with streams in the immediate vicinity, compiled by H. D. Powell, Civil Engr.

Application No. 11042
 Permit No. 7531