


G-8600  
65873  
75922

T.28S., R.15E., W.M.

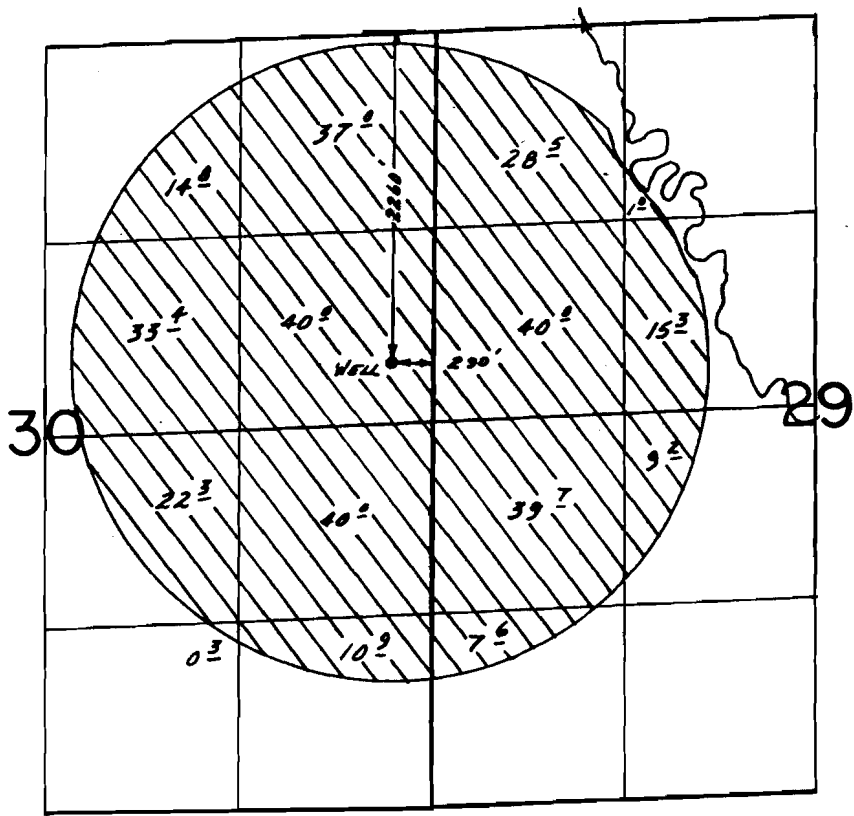

SCALE: 1" = 1320

**FINAL PROOF SURVEY**  
UNDER

Application No. G-9209. Permit No. G-8600.....  
IN NAME OF

...KENNETH & DOROTHY EMERY...

Surveyed Sept. 17, 1985, by T.M. WARREN....  
June 28 1988 B.W. BISHOP