


T.16,17S.,R.11E.,W.M.

RECEIVED

OCT 06 1998

WATER RESOURCES DEPT
SALEM, OREGON

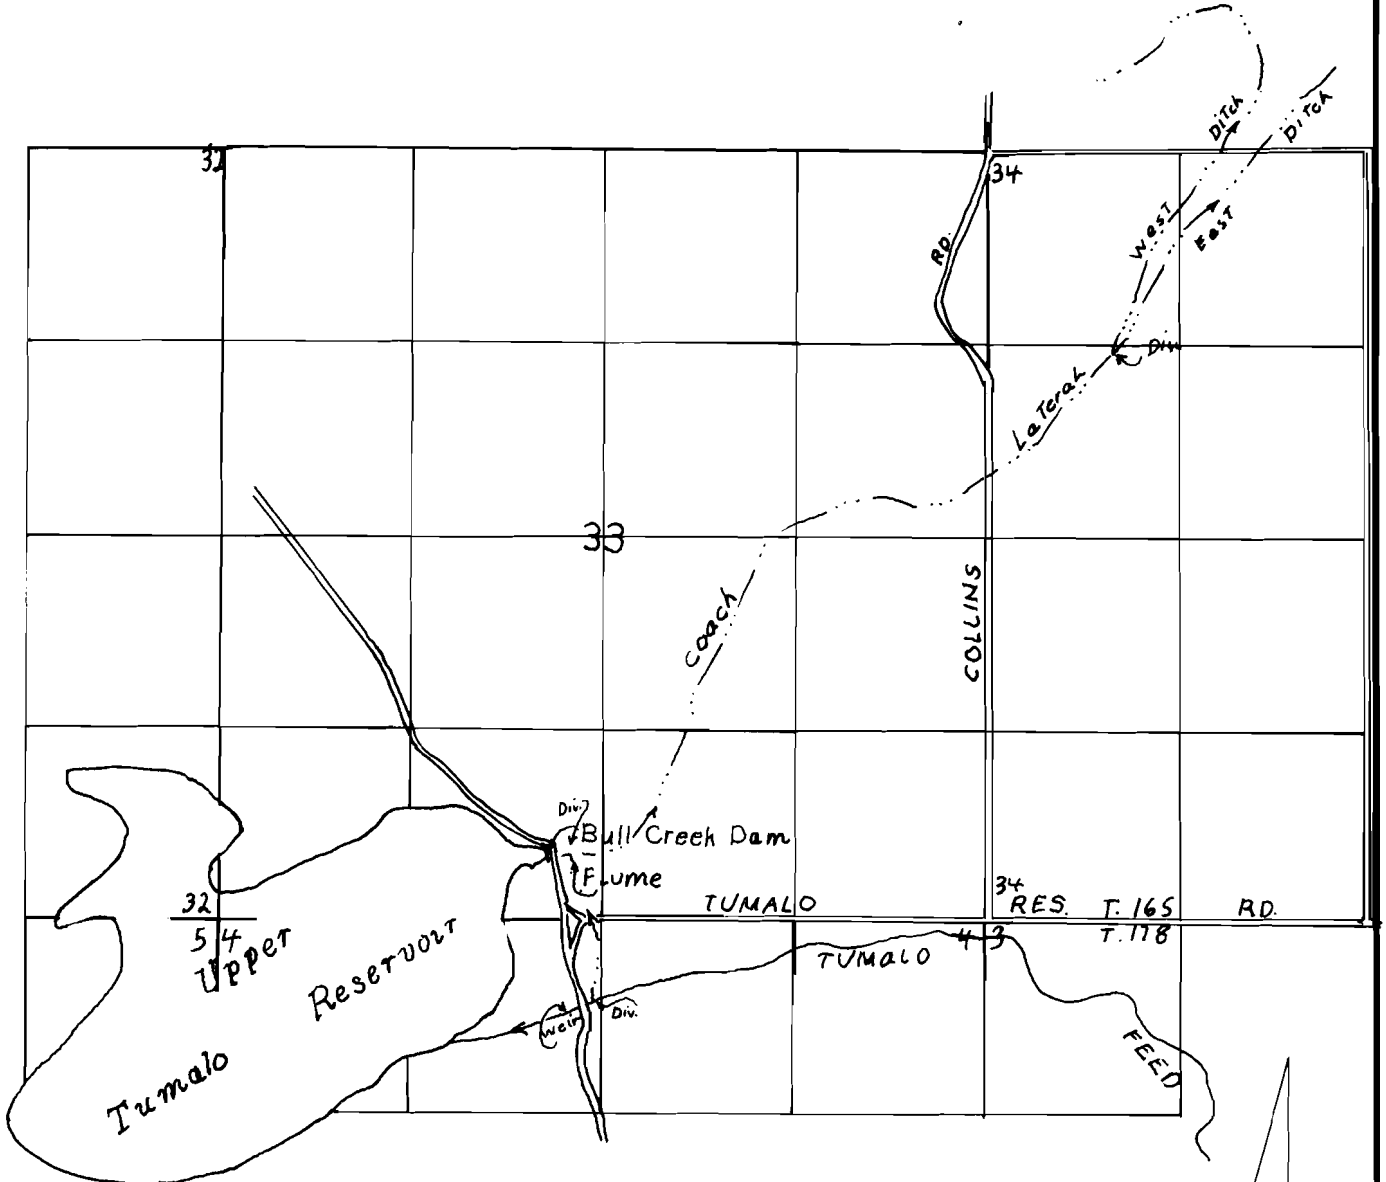


FINAL PROOF SURVEY UNDER

Application No. R-37238 Permit No. R-2743
IN NAME OF

TUMALO IRRIGATION DISTRICT

Surveyed AUG.26. 1998, by R.M.SUTTERFIELD

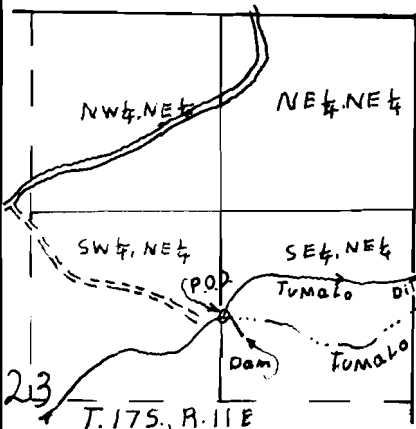

DIV. PT. 2080'S & 131.0' W FROM
NE COR. OF SEC. 23.