


RECEIVED

AUG 28 1997

WATER RESOURCES DEPT
SALEM, OREGON

T. 23 S., R 10 W., W. M.

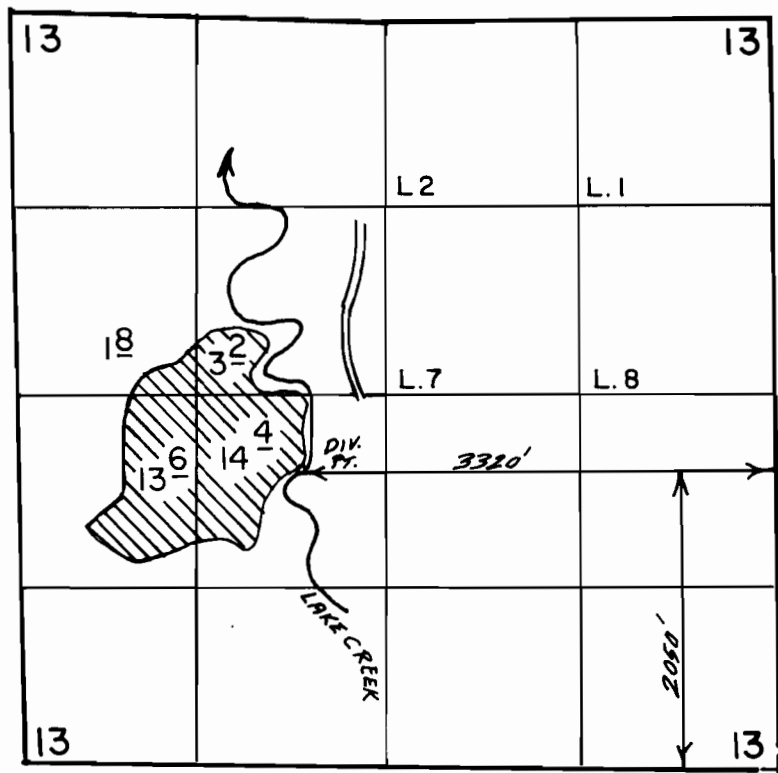

Scale 1"=1320'

FINAL PROOF SURVEY UNDER

Application No. 60860 Permit No. 45398
IN NAME OF

SUSAN CALLAHAN & PAUL & CHERYL HADDOCK

Surveyed April 16, 1996, by S. DeHaas

41000-1289-47R

QUAD MAP 8/97