


T.33S., R.1W., W.M.

RECEIVED

AUG - 4 1992

WATER RESOURCES DEPT.
SALEM OREGON

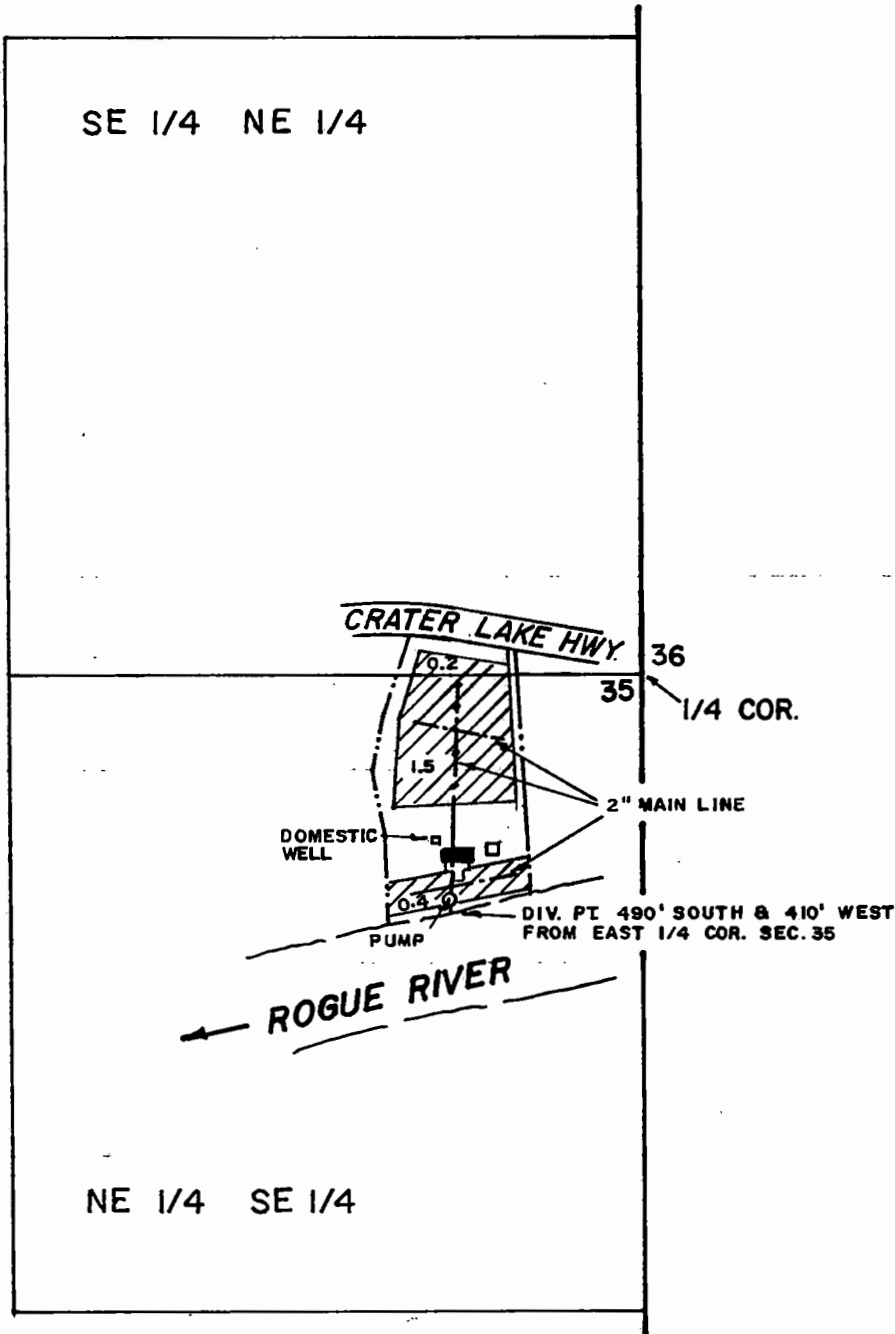

SCALE: 1" = 400'

FINAL PROOF MAP

APPLICATION NO 69698 PERMIT NO. 50424

NOTE THIS MAP HAS BEEN
PREPARED FOR WATER RIGHT
PURPOSE ONLY, NOT FOR
PROPERTY BOUNDARY LOCATIONS

IN THE NAME OF

GLENN J. BARTON & JERILYNN BARTON

MAP PREPARED JULY 29, 1992 BY GARY D. KAISER

