




FINAL PROOF MAP

T.12S.,R.1W., SECTION 20

T.12S.,R.1W., SECTION 29

APPLICATION NO. 70776

PERMIT NO. 51155

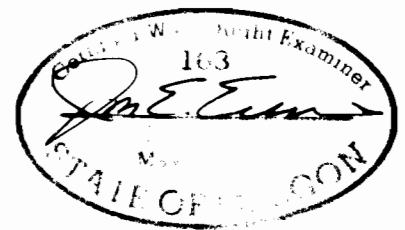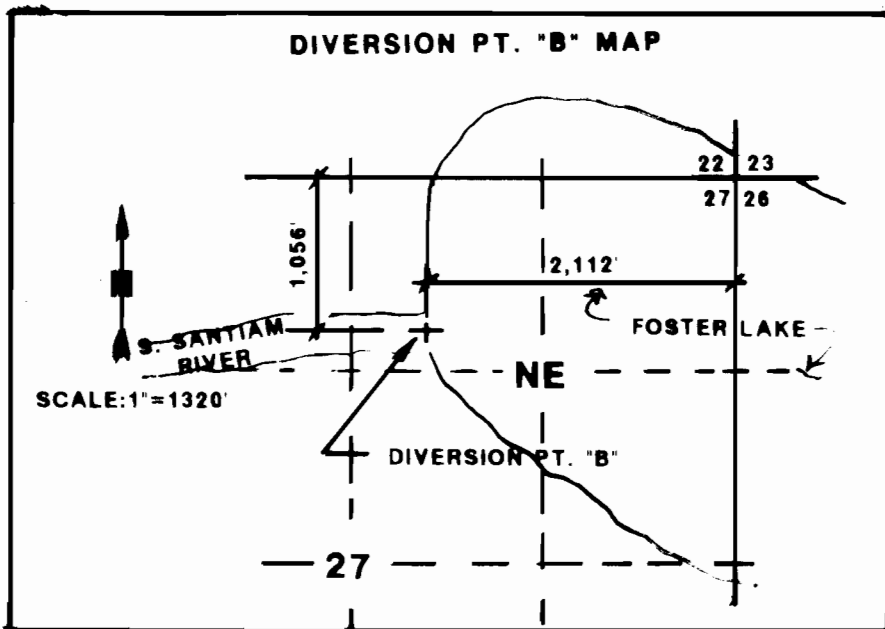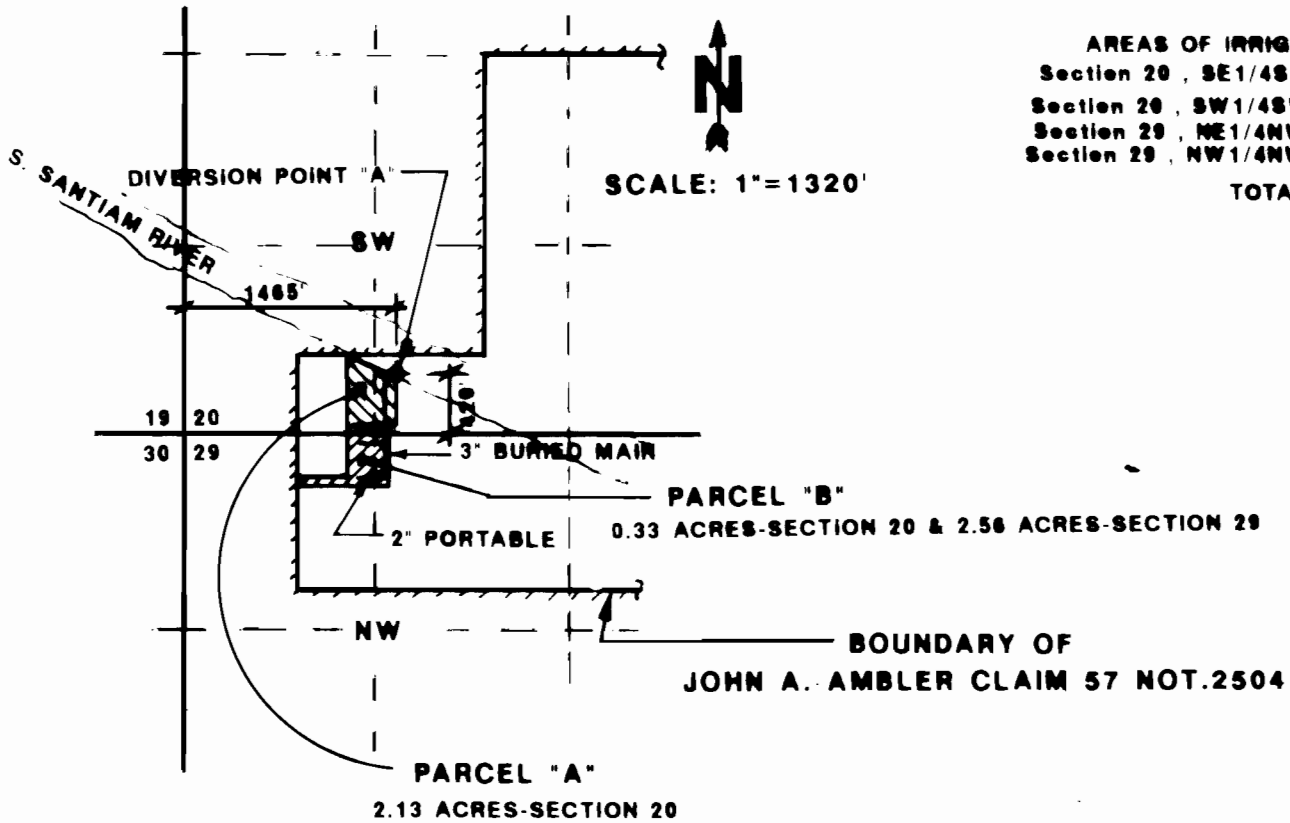

NOTE: Map is for the purpose of identifying location of water right and has no intent to dimension or locate property ownership lines.