


02261  
75929 T-6-6955  
7373

**T. 25 S., R. 18 E., W. 1 M**

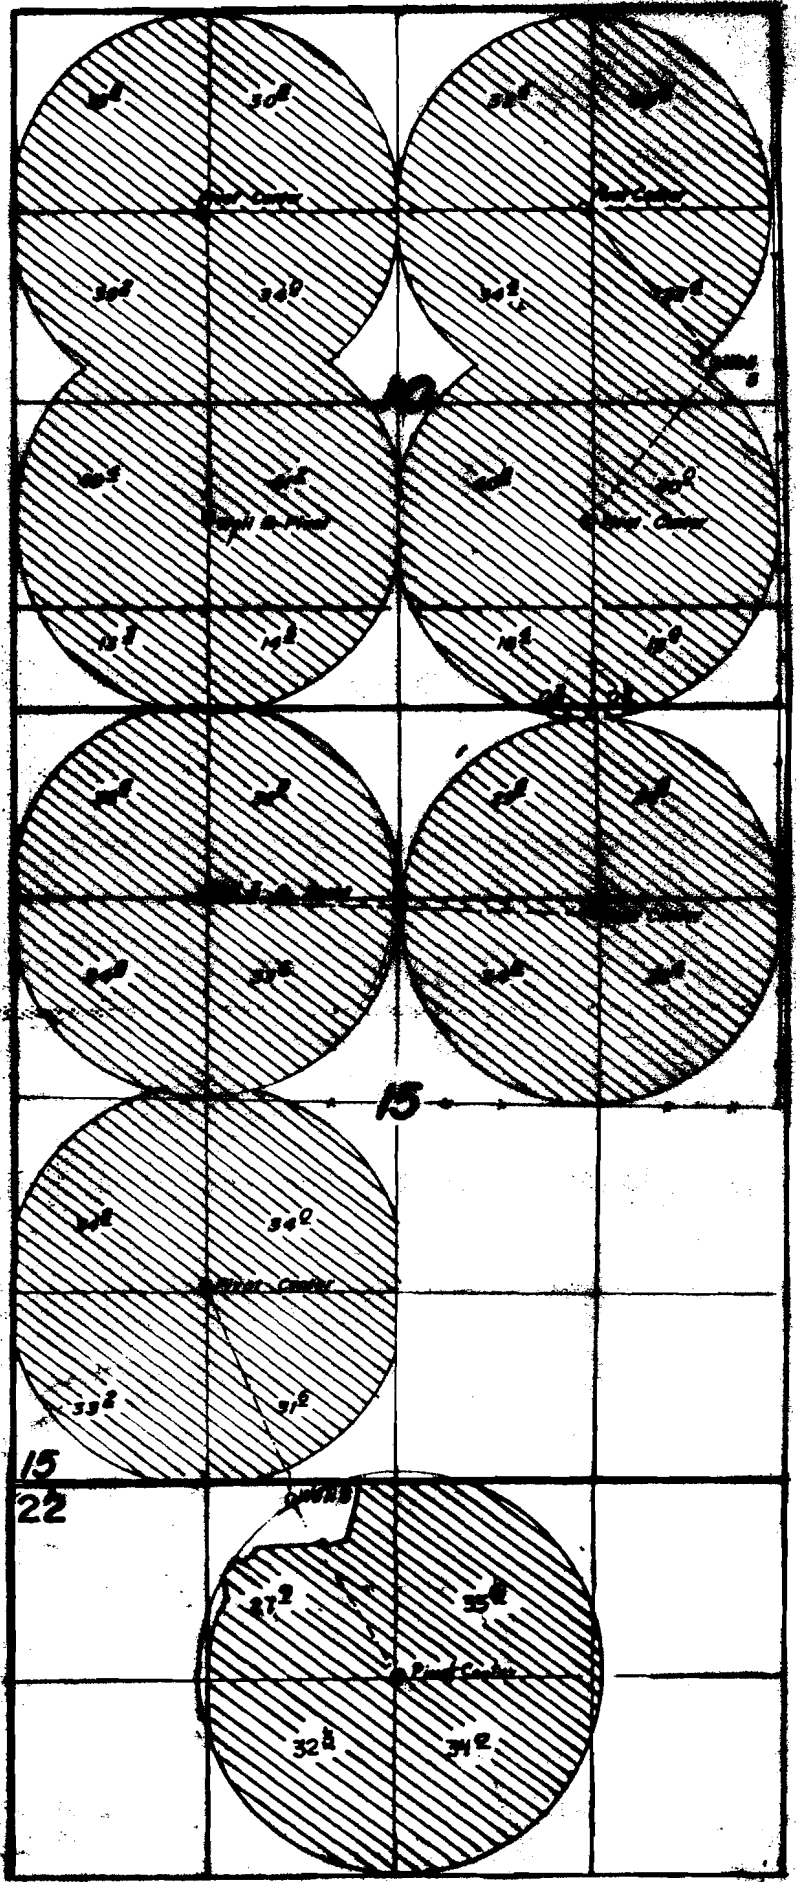

Well 1 Loc.: 1300' N @ 1340' E. from SW Cor. Sec. 15.  
 Well 2 Loc.: 1300' S @ 1300' E. from NW Cor. Sec. 15.  
 Well 3 Loc.: 2410' S @ 2400' W. from NE Cor. Sec. 15.  
 Well 4 Loc.: 180' S @ 1800' E. from NW Cor. Sec. 22.



**FINAL PROOF SURVEY**


John Hancock Mutual Life Ins. Co.

dated July 22, 1983, by L. 708

Scale: 1" = 1320'

PT-5-1983 Z