


TOWNSHIP 9 SOUTH, RANGE 3 WEST, W.M.

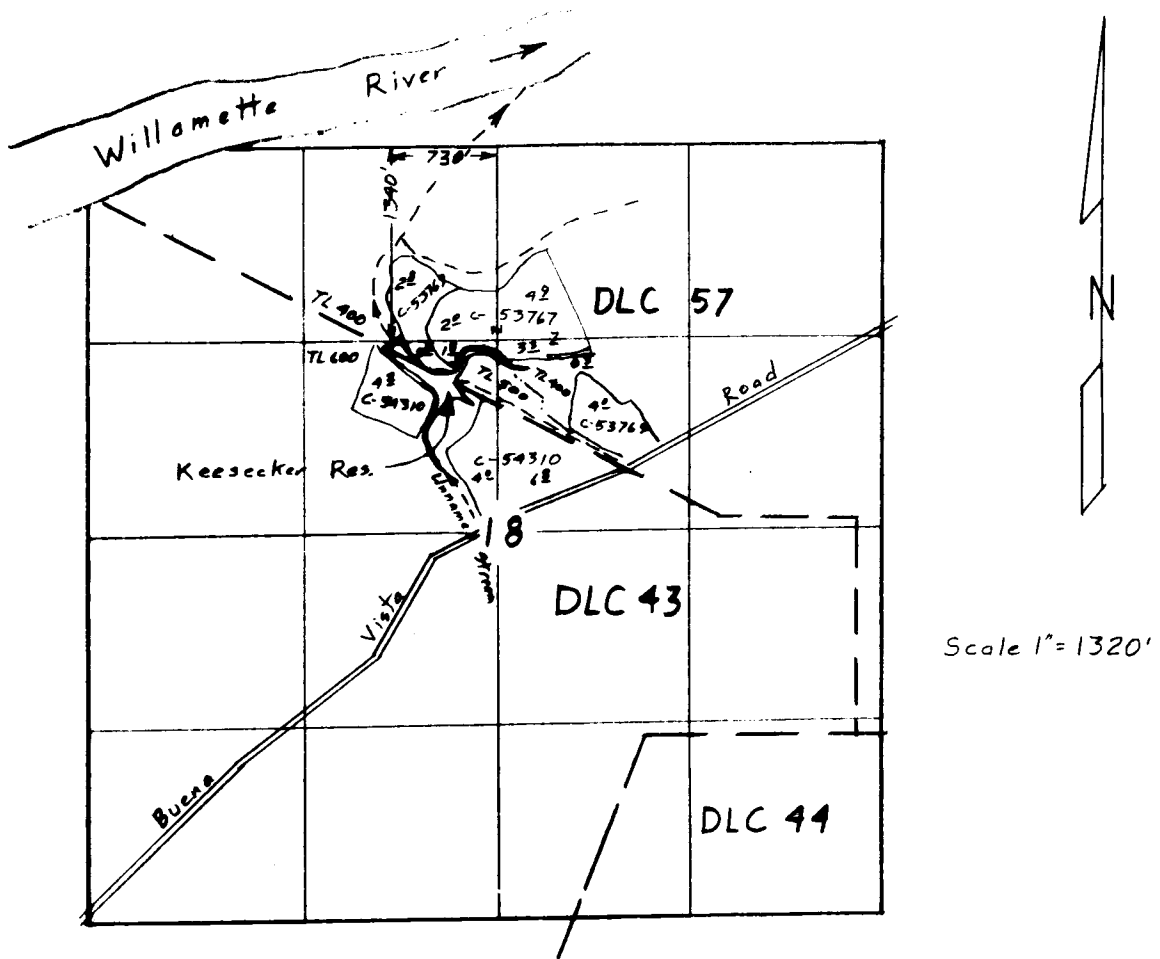

Surveyed July 1, 1998


Claim of Beneficial Use
for
ANDY KEESECKER

App R-80924
Permit R-12008

RECEIVED

JUL 3 1998

WATER RESOURCES DEPT.
SALEM, OREGON

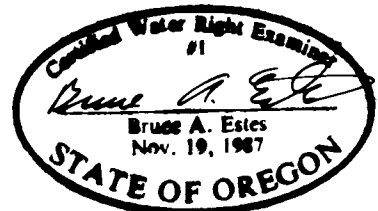

This map is for the purpose of
locating a water right only
and has no intent to provide
legal dimensions or the location
of property lines.

ESTES SURVEYS

6000 Sunnyside Rd. NE Salem, OR 97305 (503) 585-7503
60902 Arnold Rd. Bend, OR 97702 (503) 382-7391