


ON 33, TWP. 1 S. RANGE 13 E. W.M. WASCO COUNTY, OREGON

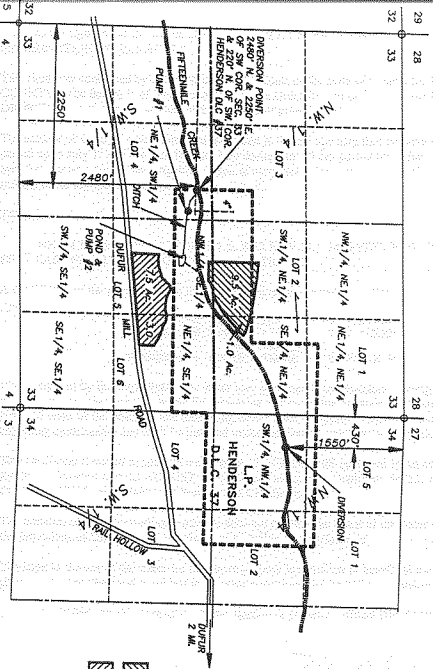

FINAL PROOF SURVEY

RIGHT TRANSFER, EXCHANGE OF PRIORITY

SCALE: 1" = 1320'

APPLICATION No. T-6277

PERMIT No. 44313 (1977)

AND CERTIFICATE No. 49488 (1856)

IN THE NAME OF:
GENE UNDERHILL

DATE: SEPTEMBER 9, 1992

 TRANSFERRED 1977 TO
 TRANSFERRED 1856 FROM
 TRANSFERRED 1977 FROM

BY: TENNESON ENGINEERING CORP.
409 LINCOLN STREET,
THE DALLES, OREGON, 97058
PH. (541) 296-9177



NOTE:
"THIS MAP IDENTIFIES THE LOCATION OF THE WATER RIGHT ONLY AND IS NOT INTENDED TO PROVIDE DIMENSIONS OR LOCATE PROPERTY OWNERSHIP LINES."

