


48587 75936

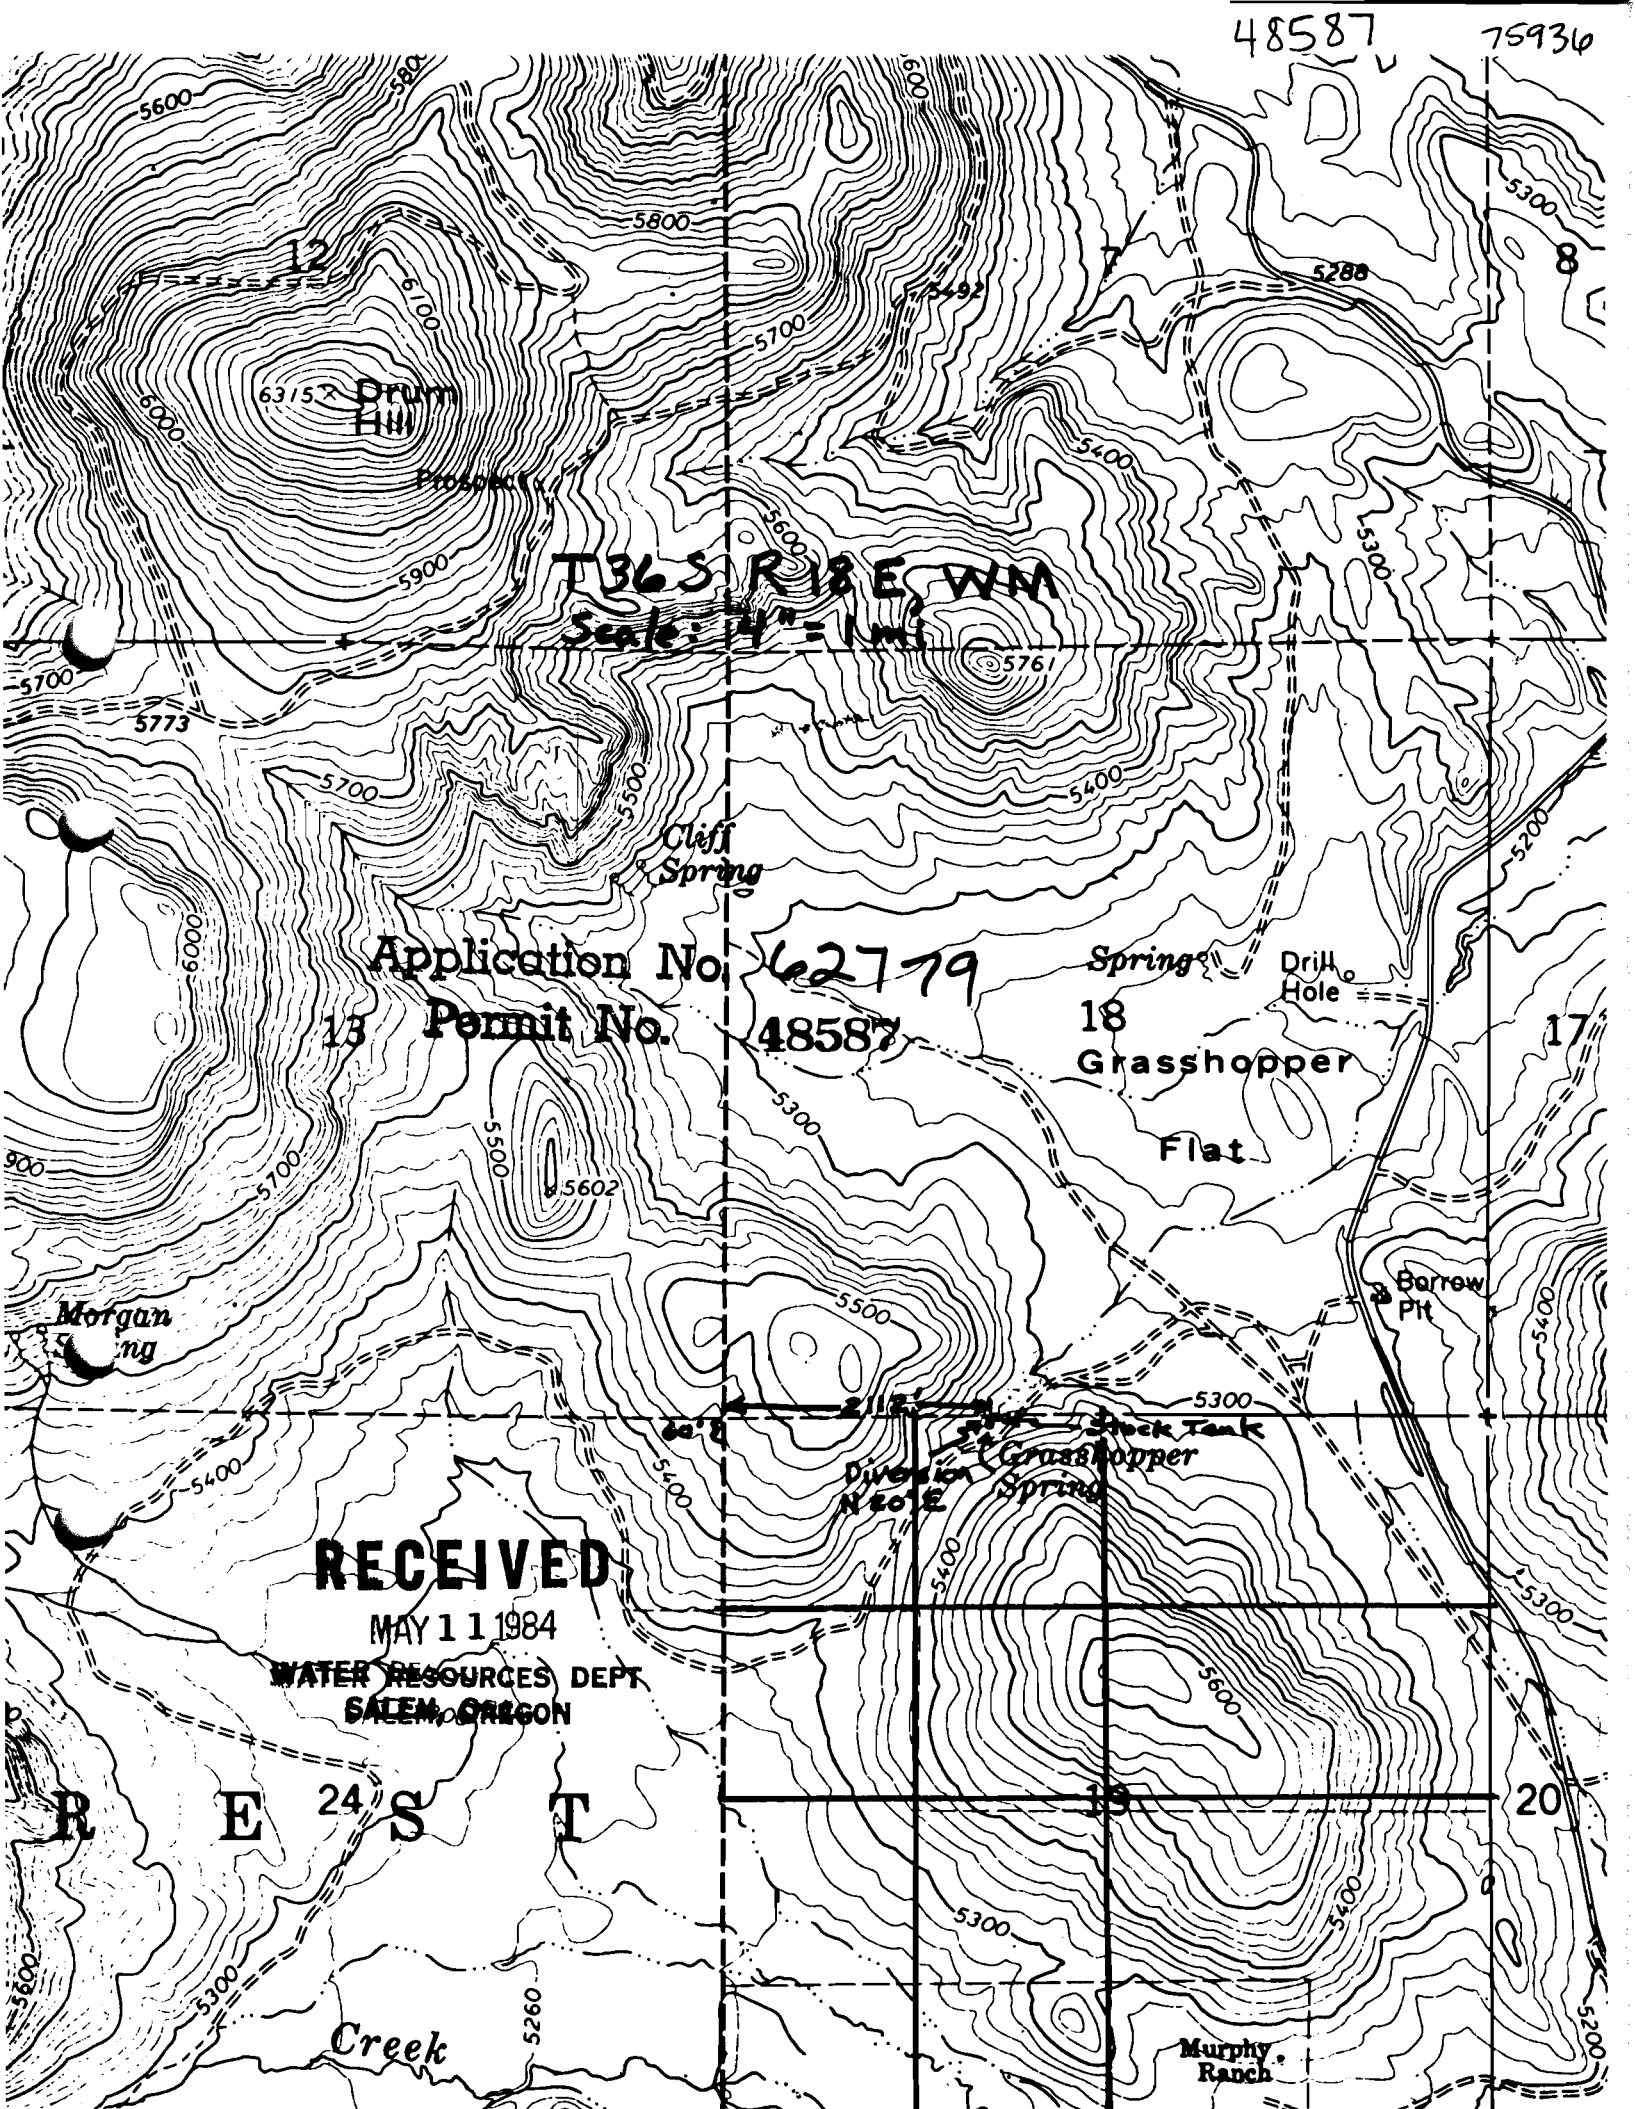

T36 S R18 E WM
Scale: 1" = 1 mi

Application No. 62779
Permit No. 48587

Spring
18
Grasshopper
Flat

RECEIVED

MAY 11 1984

WATER RESOURCES DEPT
SALEM, OREGON

R E 24 S T

Creek

Murphy Ranch