


RECEIVED

SEP 8 1983

**WATER RESOURCES DEPT.
SALEM, OREGON**

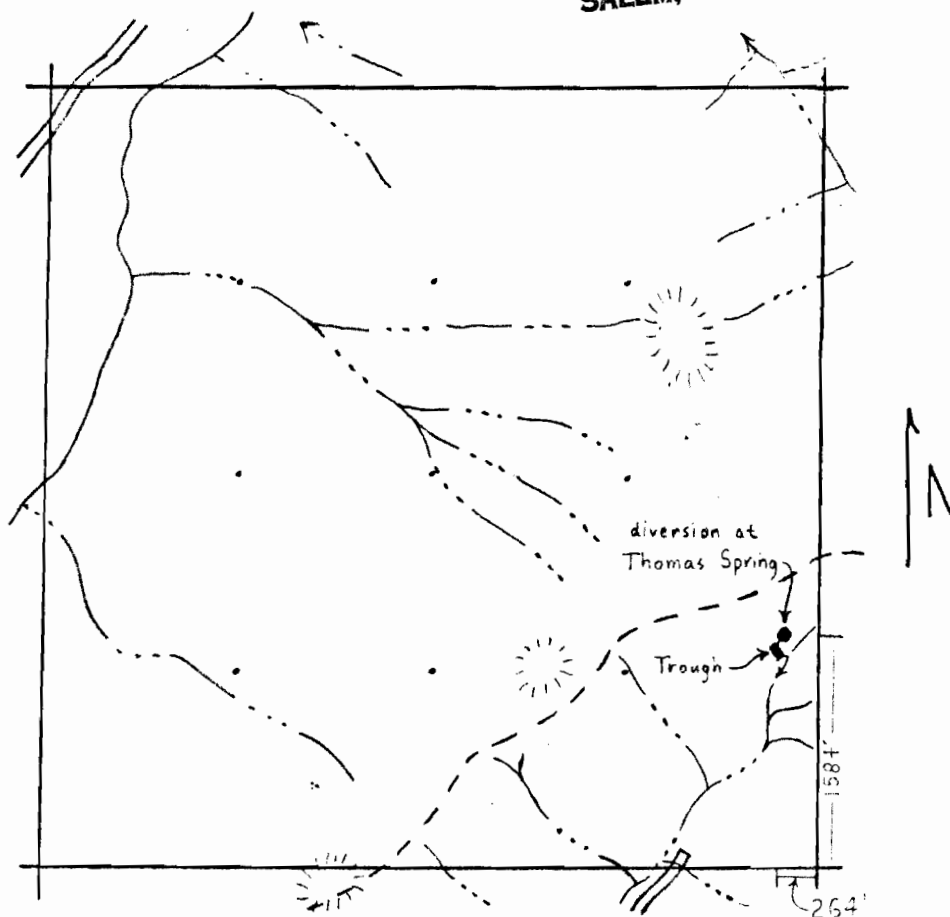

4 inches = 1 mile

T 5 S R 48 E Sec 19

Application No. 62816

Permit No. 48898