


Application No. 11085
Permit No. 7588

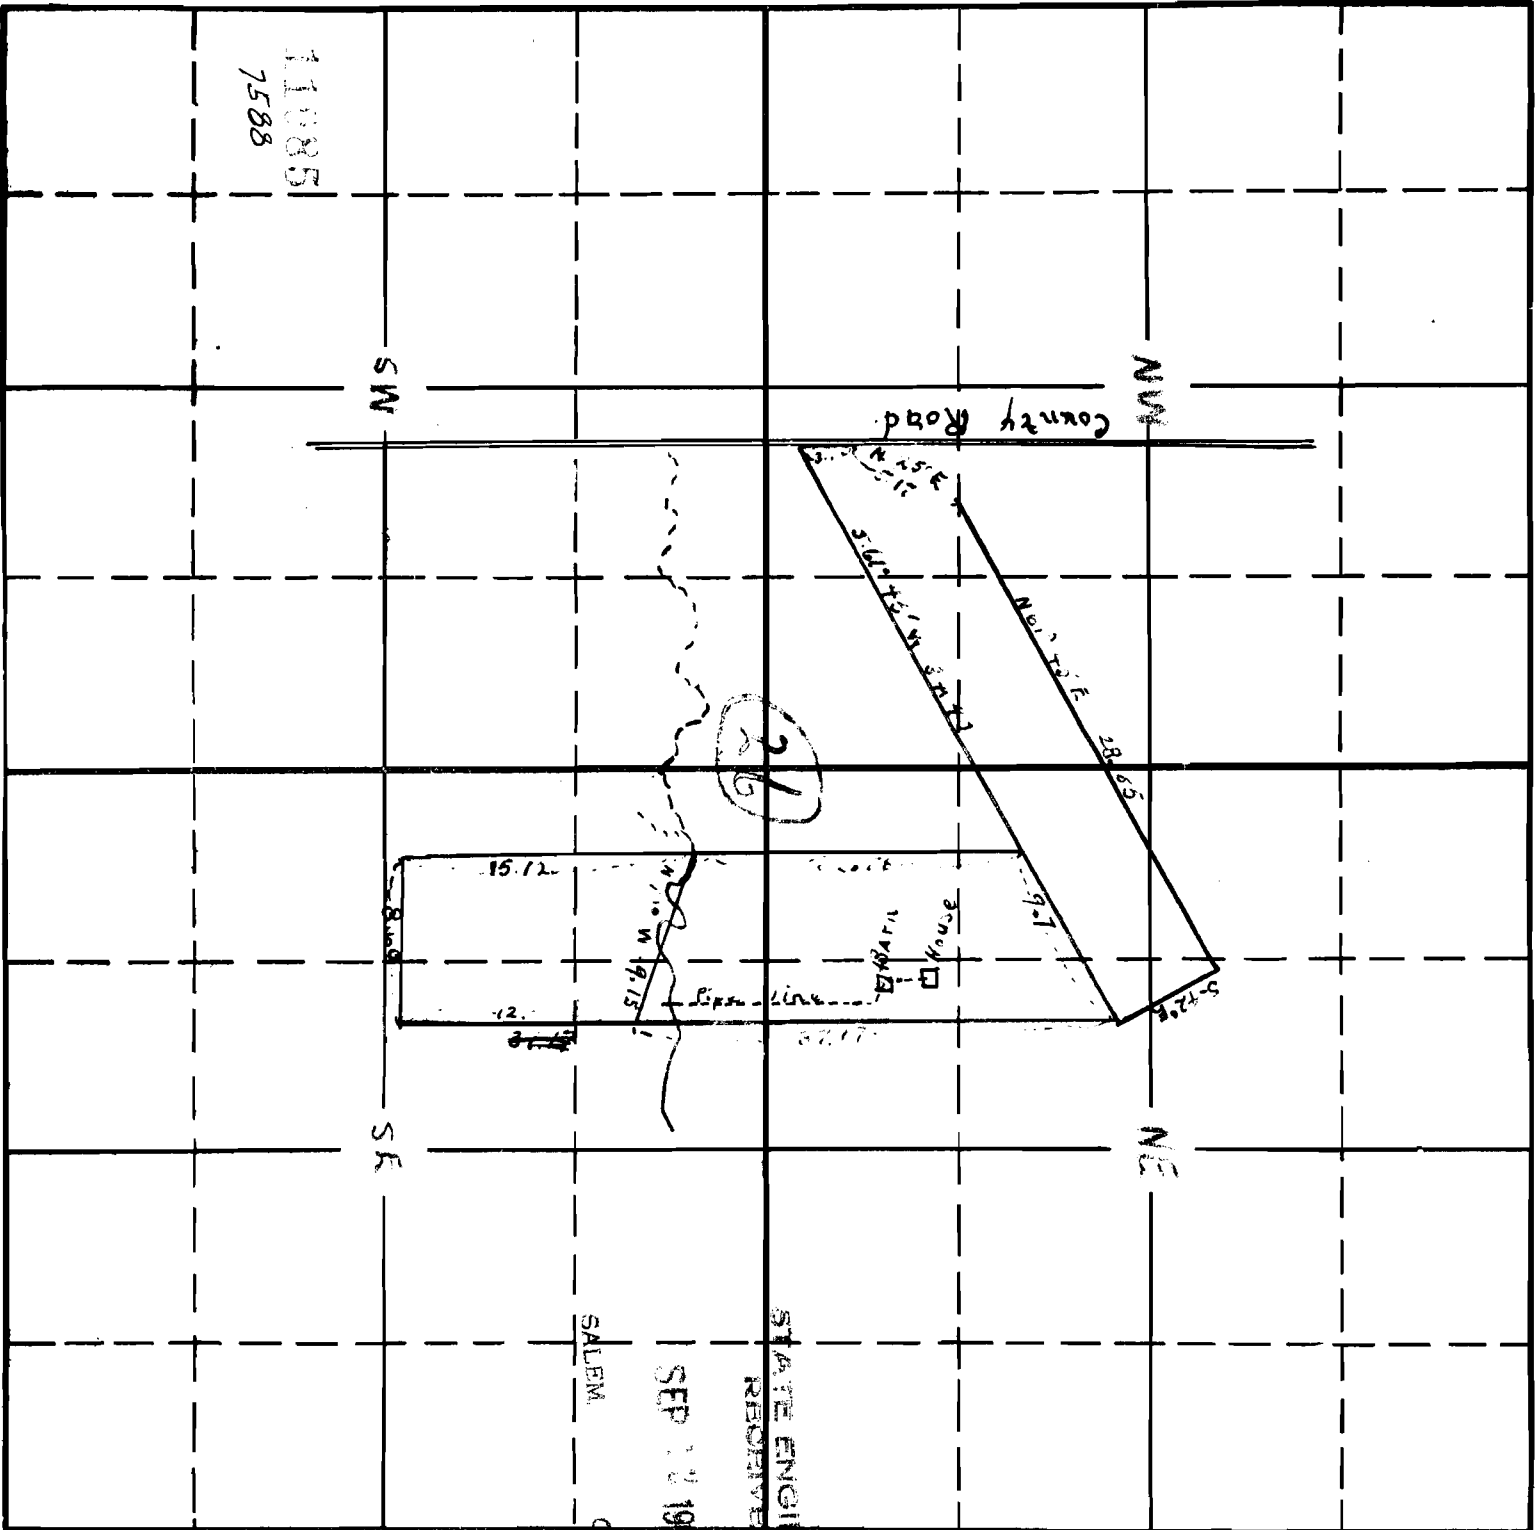

Sec. 26

Tp. 3-S

R. 1.W.

STATE ENGINEER
RECEIVED

SEP 12 1925

SALEM OREGON