


# FINAL PROOF SURVEY MAP

IN THE NAME OF GEOFFREY A. OR KATHLEEN A. STARK

SECTION 33, TOWNSHIP 30 SOUTH, RANGE 2 WEST, W.M.

APPLICATION 71951

PERMIT 51448

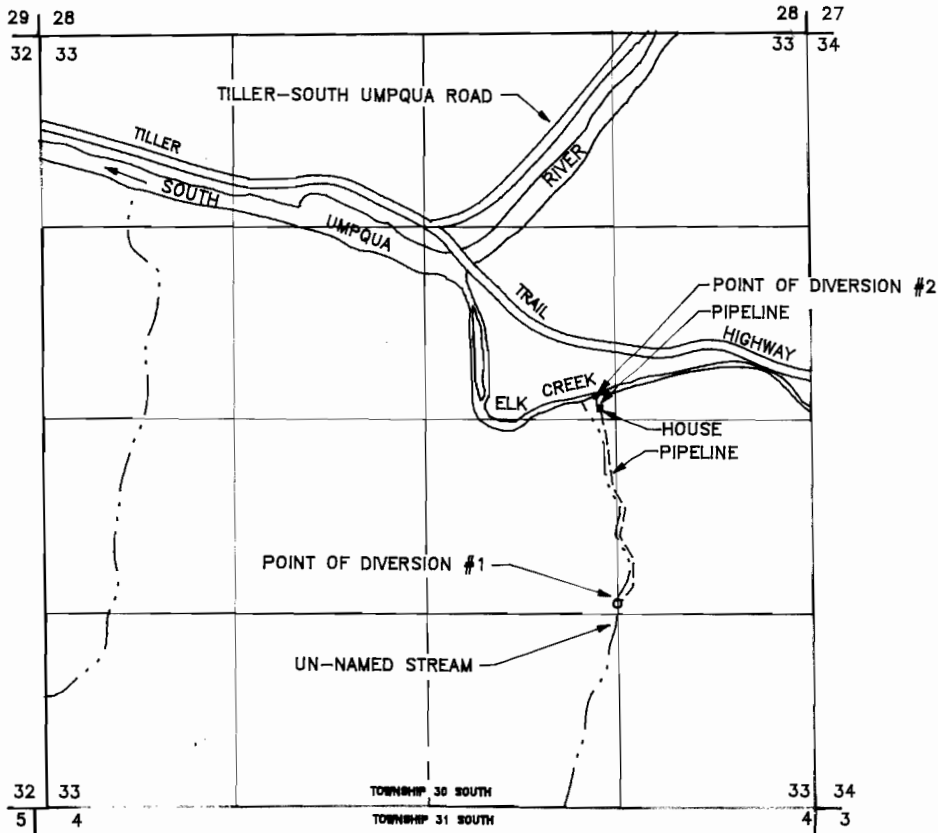

**POINT OF DIVERSION #1** IS LOCATED 1270 FEET SOUTH AND 1340 FEET WEST FROM THE EAST 1/4 CORNER OF SECTION 33, BEING WITHIN THE NW 1/4 OF THE SE 1/4 OF SECTION 33. **POINT OF DIVERSION #2** IS LOCATED 170 FEET NORTH AND 1450 FEET WEST FROM THE EAST 1/4 CORNER OF SECTION 33, BEING WITHIN THE SW 1/4 OF THE NE 1/4 OF SECTION 33, BOTH POINTS OF DIVERSION BEING WITHIN TOWNSHIP 30 SOUTH, RANGE 2 WEST, W.M., DOUGLAS COUNTY.

THE PURPOSE OF THIS MAP IS TO IDENTIFY THE LOCATION OF THE WATER RIGHT. IT IS NOT INTENDED TO PROVIDE INFORMATION RELATIVE TO THE LOCATION OF PROPERTY OWNERSHIP BOUNDARY LINES.

