


Tax Lot No. TL600 23 12 21BC
Section 21 Township 23S Range 12W W.M.
Coos County

RECEIVED

NOV - 6 1997

WATER RESOURCES DEPT.
SALEM, OREGON

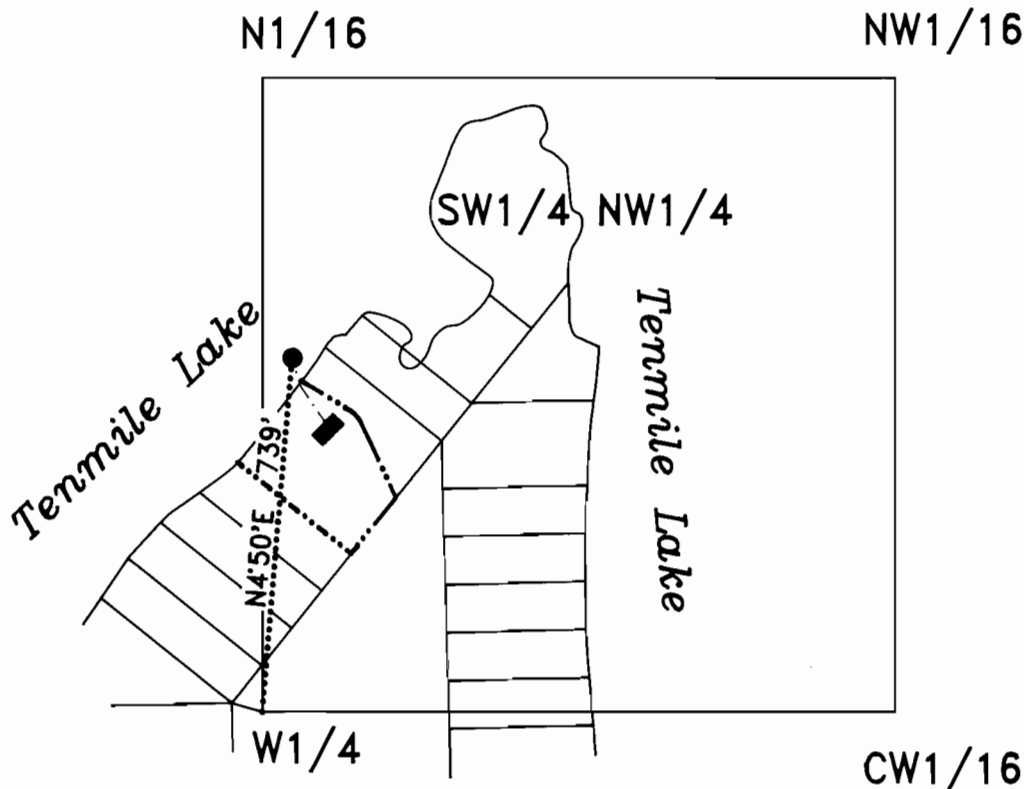


Scale 1" = 400'

Legend

- P.O.D.
- Property Line
- Waterline
- House

EXAMINERS DISCLAIMER STATEMENT

The preparation of this map was for the purpose of identifying the location of the Water Right only and has no intent to provide dimensions or location of property ownership lines.

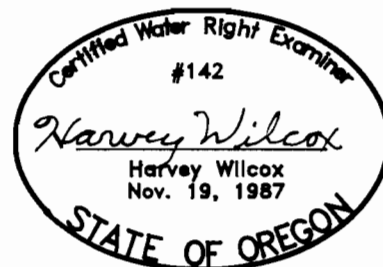

RENEWAL 6/30/98

FINAL PROOF SURVEY
IN THE NAME OF

James E. and Geraldine J. Paavola

Surveyed on 10/2/97 by H.A. Wilcox

Application No. S-81273

Permit No. 53176