


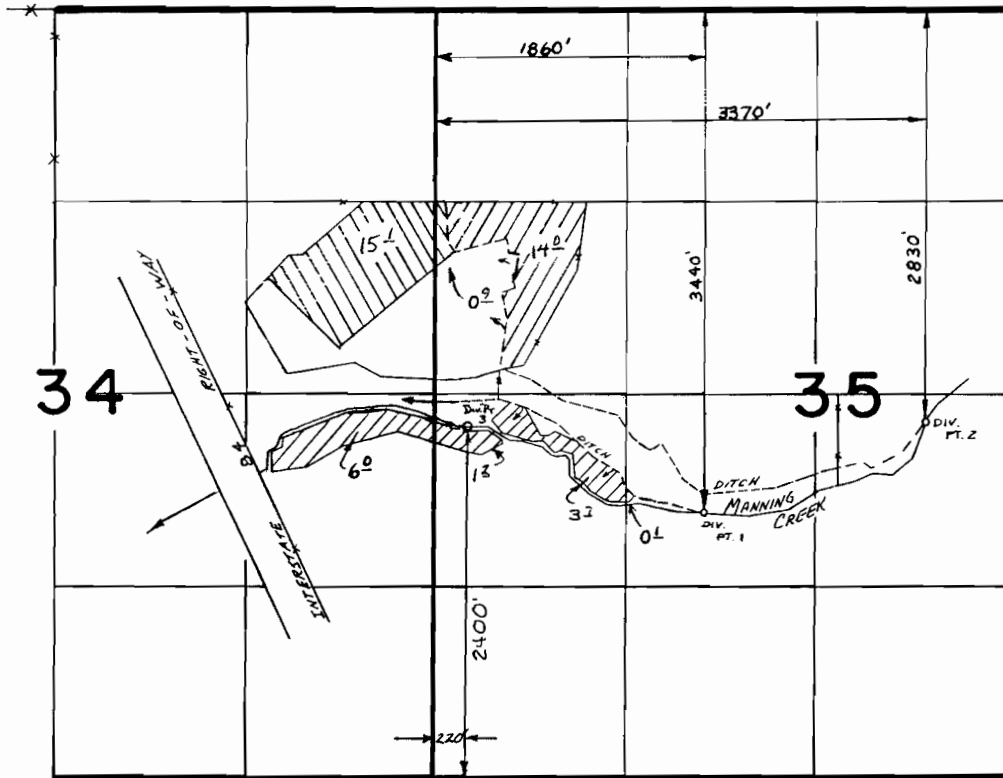


T. 11S., R. 43E. W. M.



 T-3639

 PER. 42791

 PER. 42790

FINAL PROOF SURVEY
UNDER

TRANSFER 3639

55749 42790

Application No. 55750 Permit No. 42791

IN NAME OF

EDWIN AND BEVERLY WHITE

Surveyed 10-31-1978 by R. BARWIN
8-1-79 V. CHURCH & JARRETT
86 D. Clark

SCALE: 1" = 1320'



1169 W FOR TEE (Gould) 9/29/86 V.L.C.
PTS-1978-P-E 2/12/86 LMT
PTS-1979-P-E V.L.C.

PROPORTIONAL MAP 2/12/86 LMT. 11/16/87 (K)