


T. 31 S. R. 4 W. W.M.

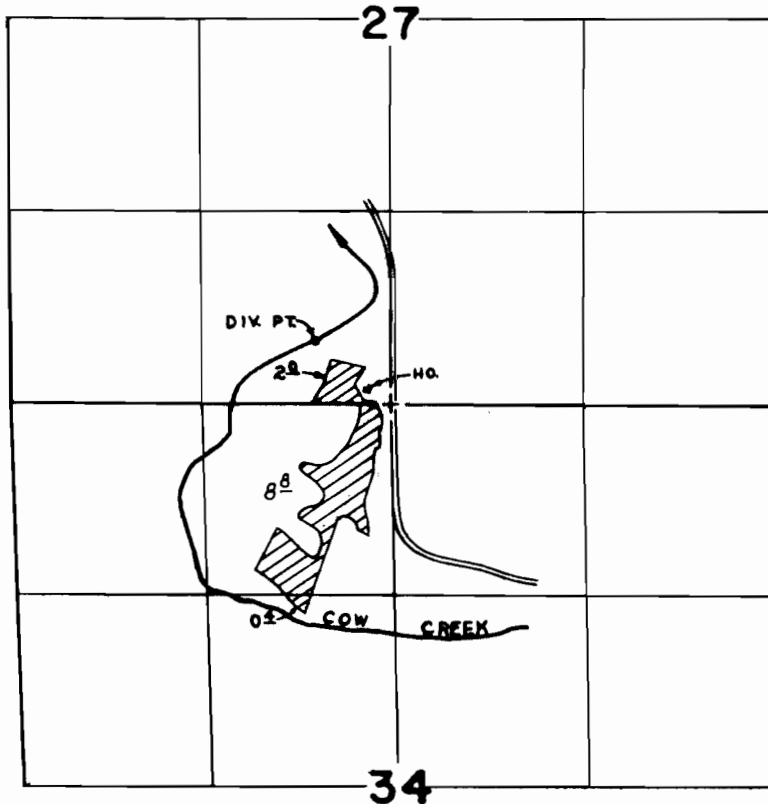

DIV. PT. LOCATED 430' N. & 530' W. FROM 1/4 CORNER SECTIONS 27 & 34

SCALE : 4" = 1 mile

FINAL PROOF SURVEY UNDER

Application No. 57541.. Permit No. 43360....
IN NAME OF

ROBERT S. & CAROL M. SANDERS

Surveyed FEB. 28, 1984, by J. CASHION...