


T.29S.R.14 W.W.M.

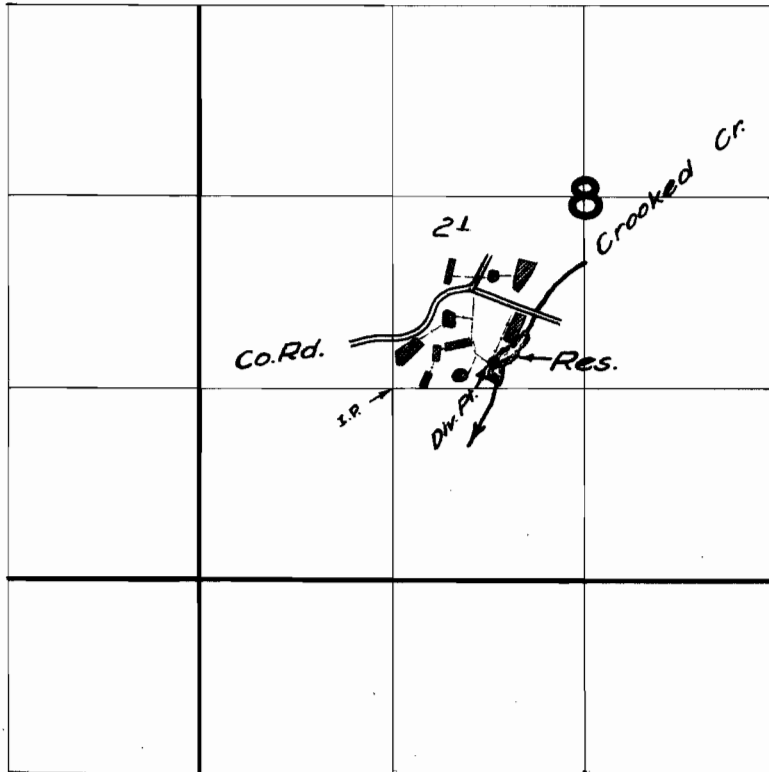

FINAL PROOF SURVEY
UNDER

R-23826 *R-1031*
Application No. 23827 Permit No. 19433
IN NAME OF

James E. Hawley

Surveyed April 19 1958, by Tm. Bush