


T. 8S. R. 42E. W. M.

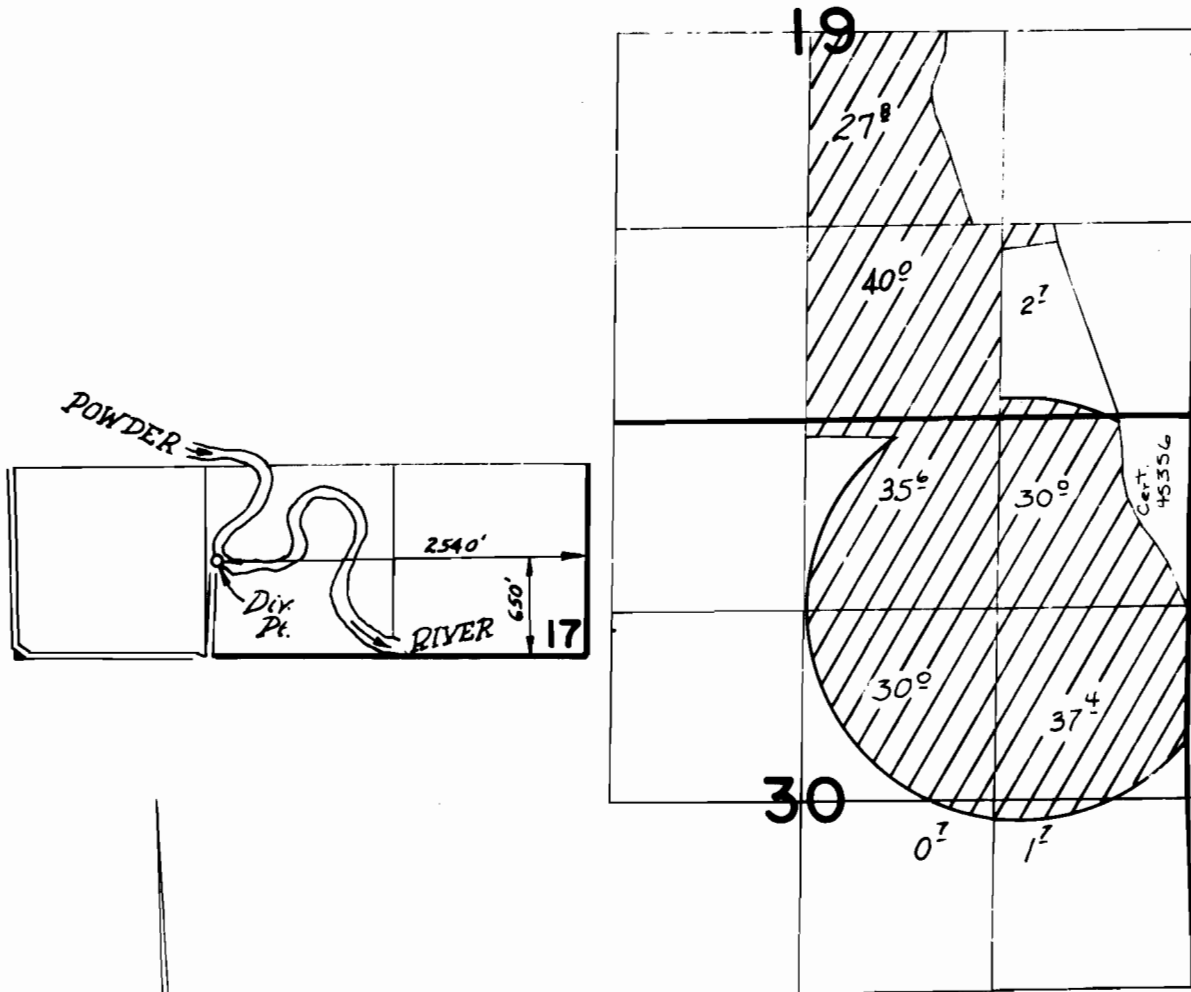

SCALE: 1" = 1320'

FINAL PROOF SURVEY
UNDER

Application No. **48622** Permit No. **36473**
IN NAME OF

.....LEE G. BATES.....

Surveyed 7-29 1978, by V. Church & D. Jauett
8-25 86 V. L. Church