


T.12S.,R.6W.,W.M.

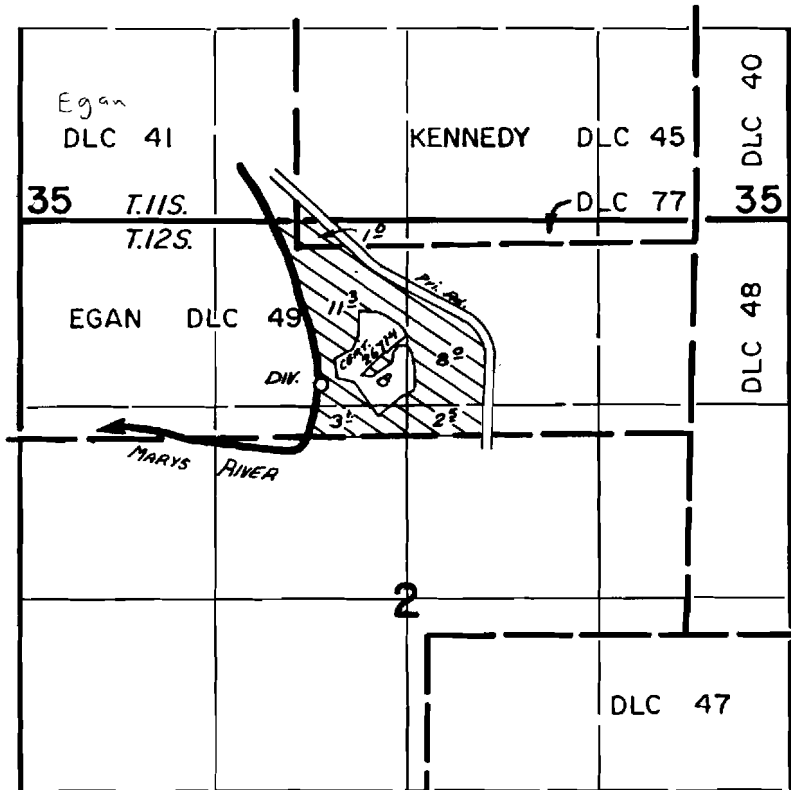

DIV. LOC: 950 ft. S. and 170 ft. E. from the SW Cor. Kennedy DLC 77

FINAL PROOF SURVEY UNDER

Application No. 57235 Permit No. 43042
IN NAME OF

ESTATE OF EDWARD C. HOWARD

Surveyed Sept. 10, 1982, by L. TOLL