


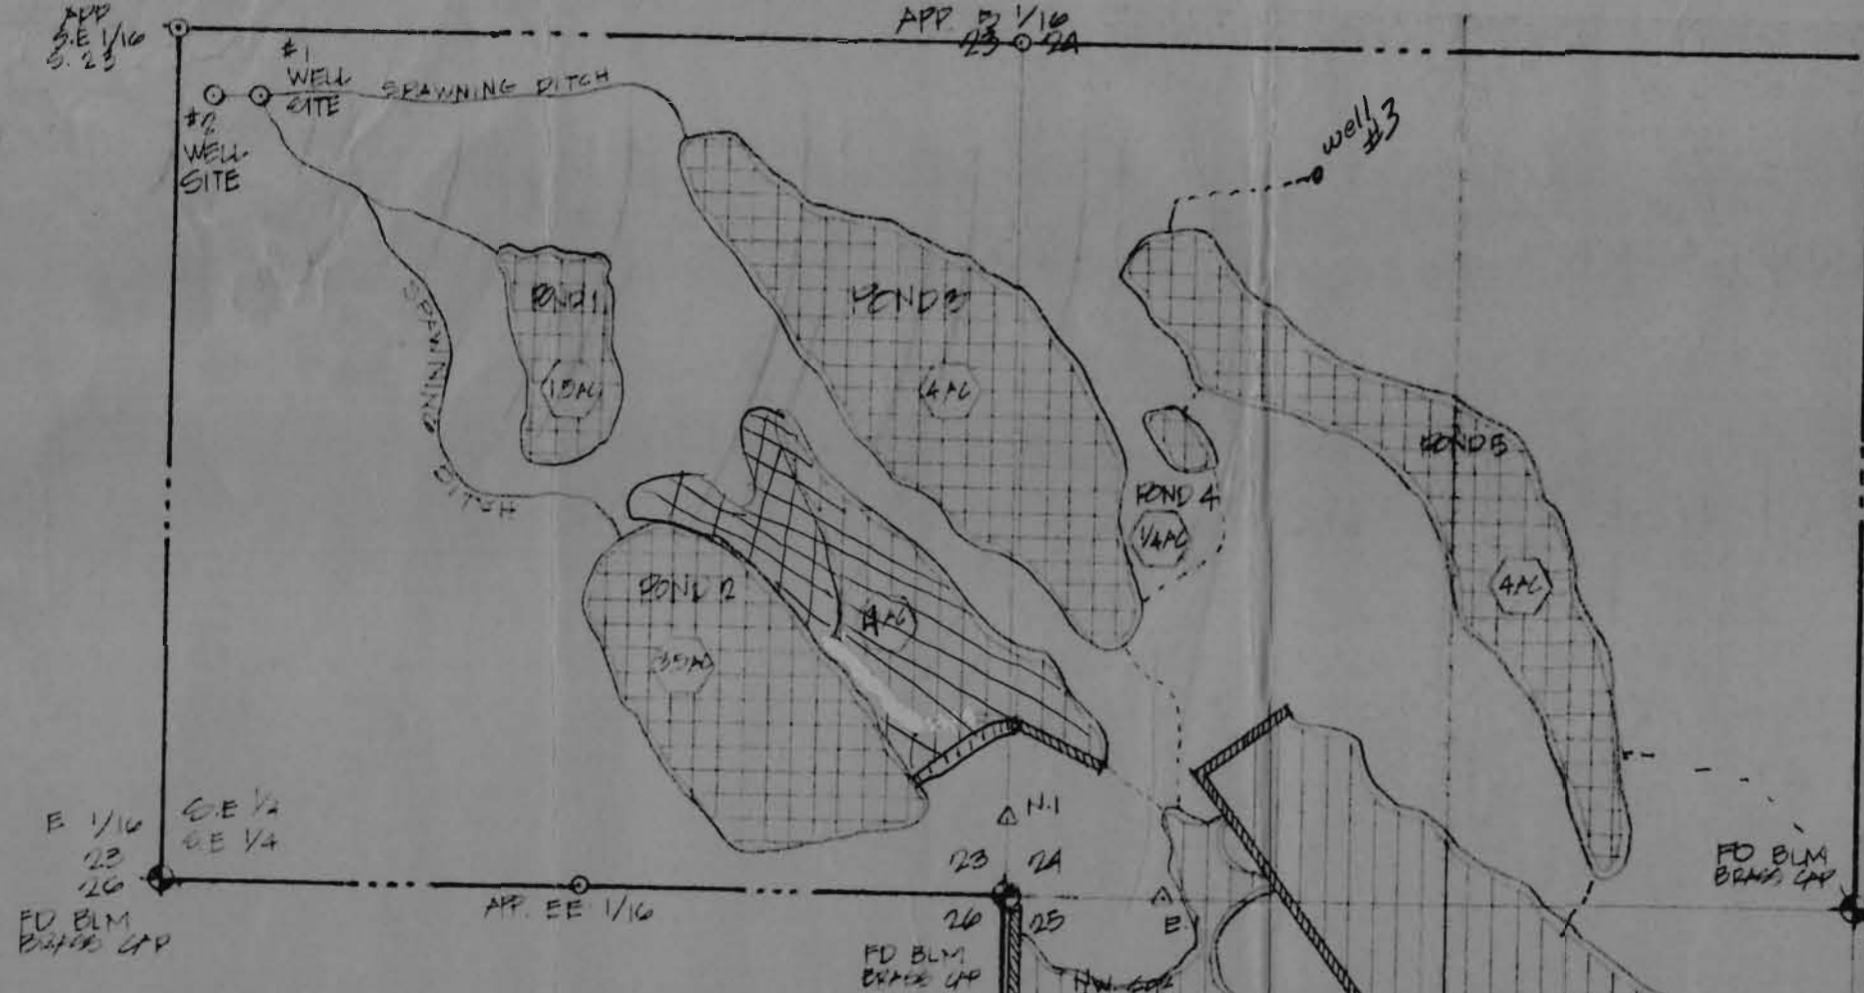

POND LOCATION SURVEY FOR LAKE IN THE DUNES T 29 S - R 17 E - W. M SECS 22, 23, 24, 25

RECEIVED
SEP 24 1998
WATER RESOURCES DEPT.
SALEM, OREGON

APPLICATION G-11446
PERMIT G-10580
FINAL PROOF MAP

[Signature]




SURVEY BY
GEORGE HARTMAN
RPLS 09/12/70
61500 SV TANYA CR
BEND, OR 97021
503-389-3614

DATE SEPT 12, 1985
TRAILED AND REVISED OCT 29, 1985
DESKTOP DRAFTING + DESIGN

WELL #1
WELL IS LOCATED APPROX. 1100 FT WEST &
1200 FT NORTH OF THE SE CORNER
SECTION 23 FIELD LOCATED.


WELL #2
WELL IS LOCATED APPROX. 1320 FT WEST &
1220 FT NORTH OF THE SE CORNER
SECTION 23 FIELD LOCATED.

WELL #3
WELL IS LOCATED APPROX. 1050 FT
FT EAST OF THE SE CORNER
SECTION 23 FIELD LOCATED.

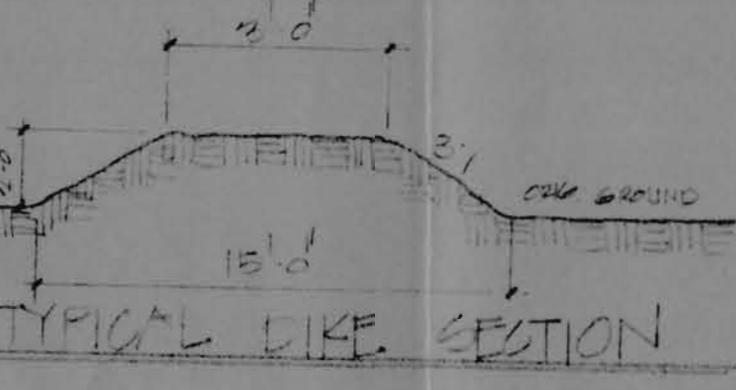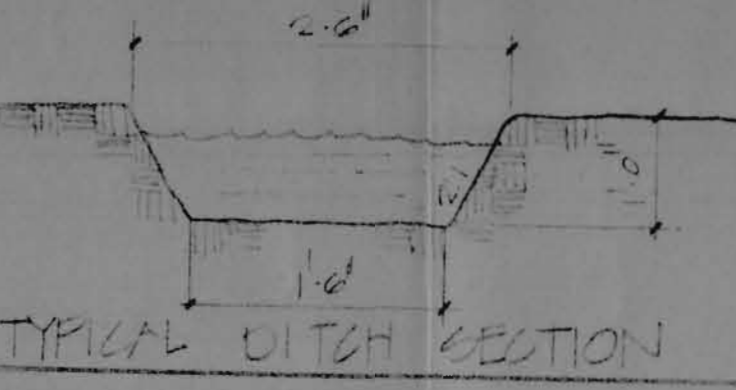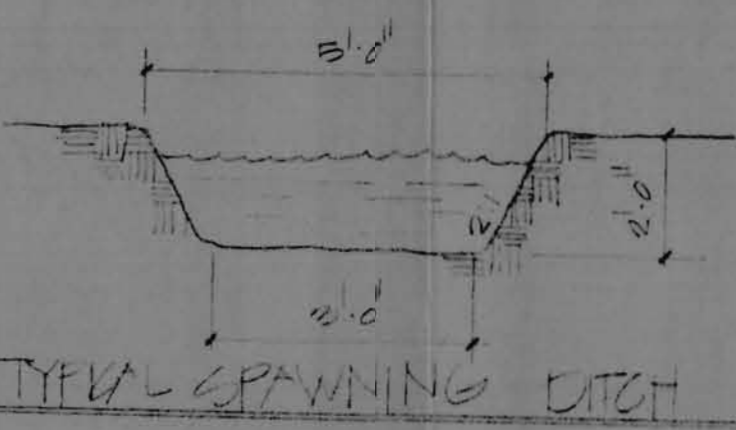


- LEGEND**
- WILDLIFE HABITAT
 - FISH REARING - WILDLIFE HABITAT
 - DITCH
 - DYKE
 - SPAWNING DITCH
 - NUMBER OF MORE PER 40 ACRES

Application No. G-11446
Permit No. G10580

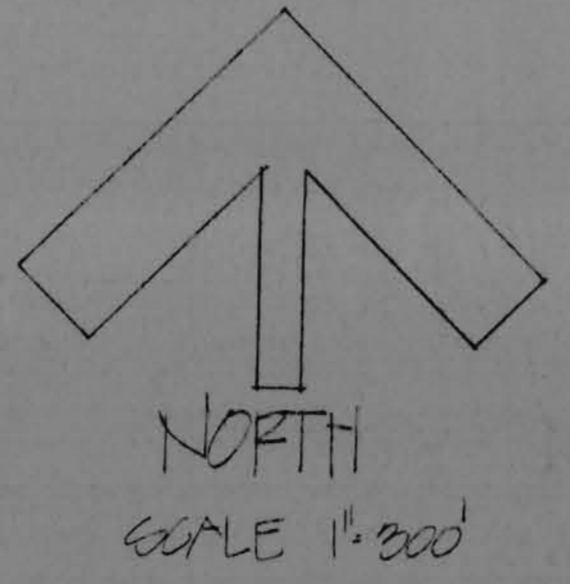


24 19
25 20

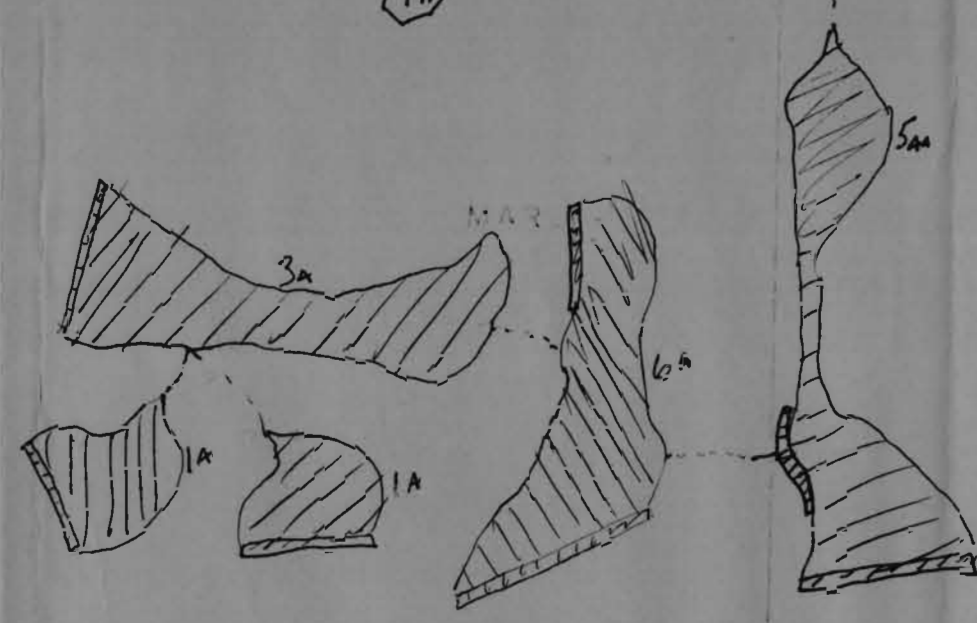

RECEIVED
SEP 24 1998
WATER RESOURCES DEPT.
SALEM, OREGON

480 ac.
(12 @ 40 ac = 480 ac.)

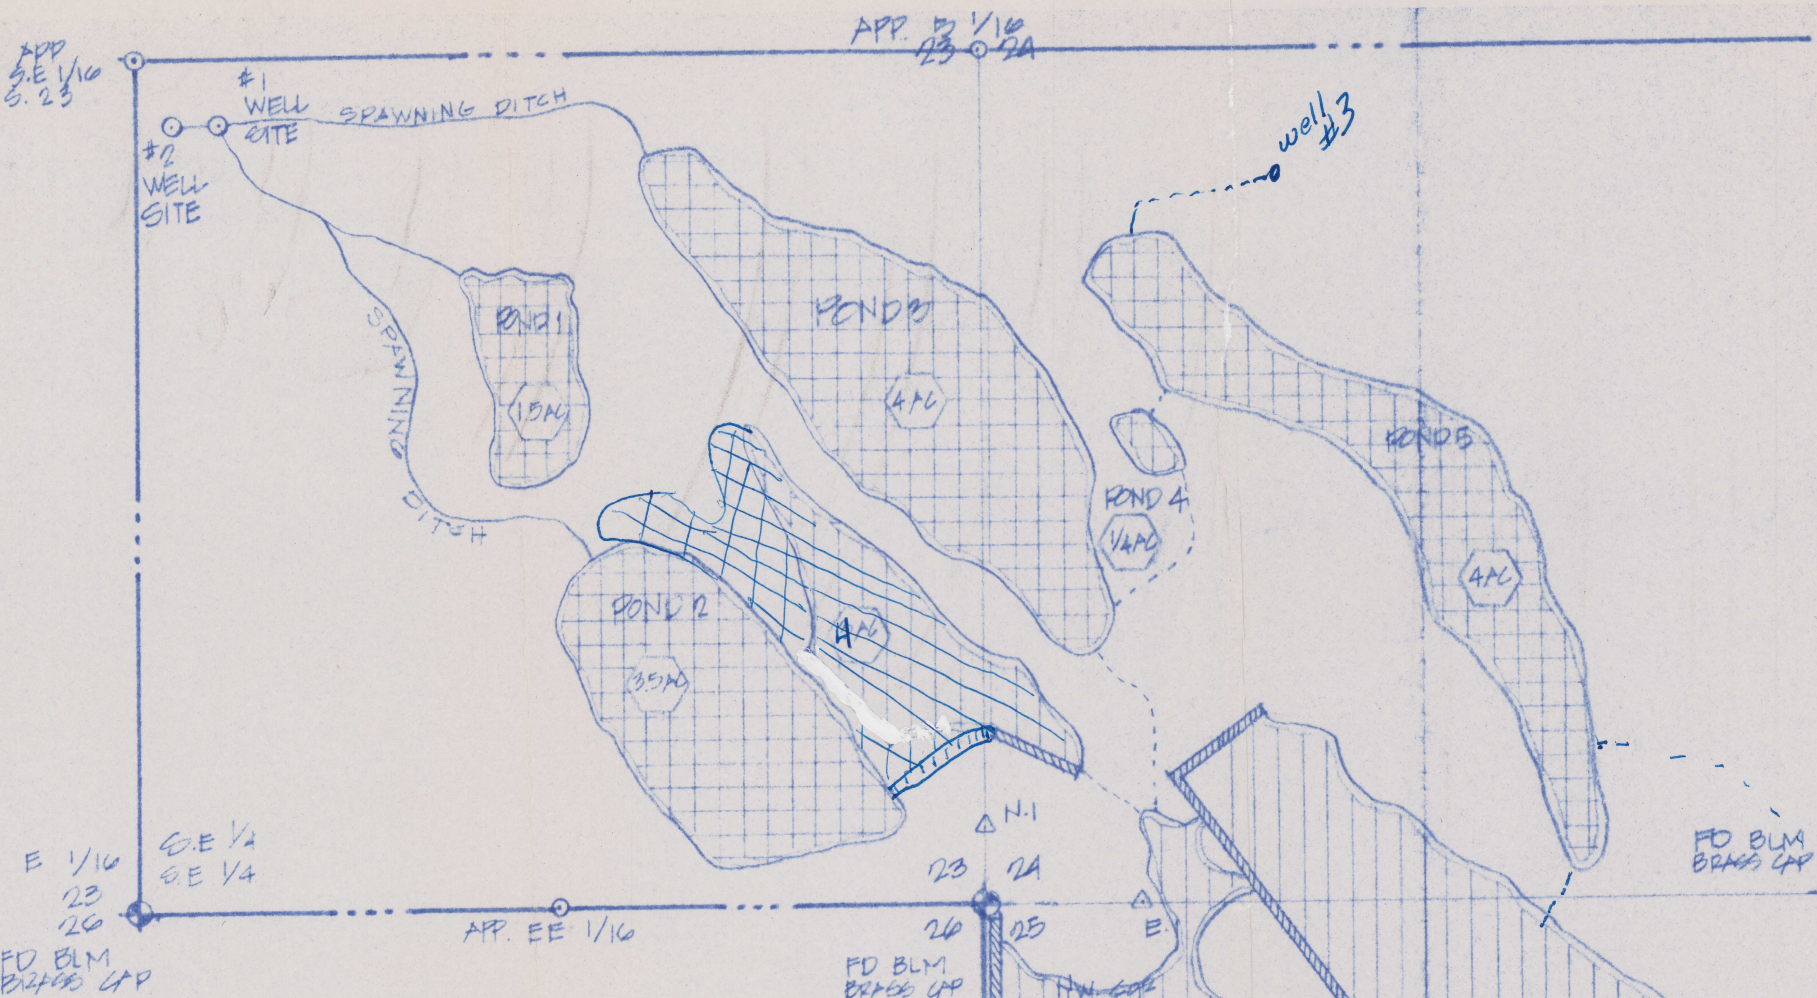

POND LOCATION SURVEY FOR LAKE IN THE DUNES T 29 S - R 17 E - W. M SECS 22, 23, 24, 25

RECEIVED

SEP 24 1998

WATER RESOURCES DEPT.
SALEM, OREGON

APPLICATION G-11446
PERMIT G-10580
FINAL PROOF MAP


SURVEY BY:
GEORGE HARTMAN
RPLG 09/20/90
61500 SW TANYA DR.
BEND, OR 97702
503-389-3614

DATE: SEPT 12, 1985
TRACED AND REVISED OCT 22 1985
DECHUTES DRAFTING & DESIGN

WELL #1
WELL 10 LOCATED APPROX. 1190 FT WEST &
1200 FT NORTH OF THE SE CORNER
SECTION 23 FIELD LOCATED.


WELL #2
WELL 10 LOCATED APPROX. 1230 FT WEST &
1220 FT NORTH OF THE SE CORNER
SECTION 23 FIELD LOCATED.

WELL #3
WELL 10 LOCATED APPROX. 1050 FT
FT EAST OF THE SE CORNER
SECTION 23 FIELD LOCATED.

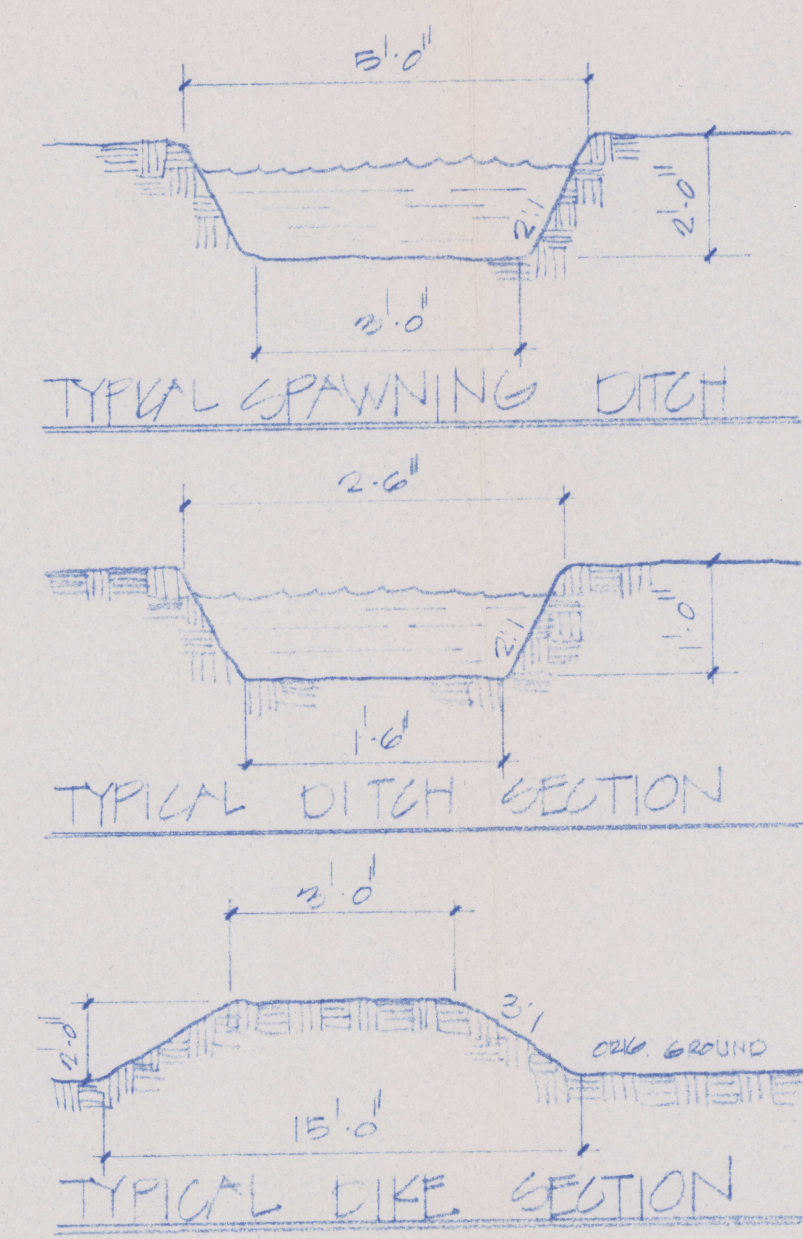


LEGEND

- WILDLIFE HABITAT
- FISH REARING - WILDLIFE HABITAT
- DITCH
- DYKE
- SPAWNING DITCH
- NUMBER OF POLE PER 40 POLES

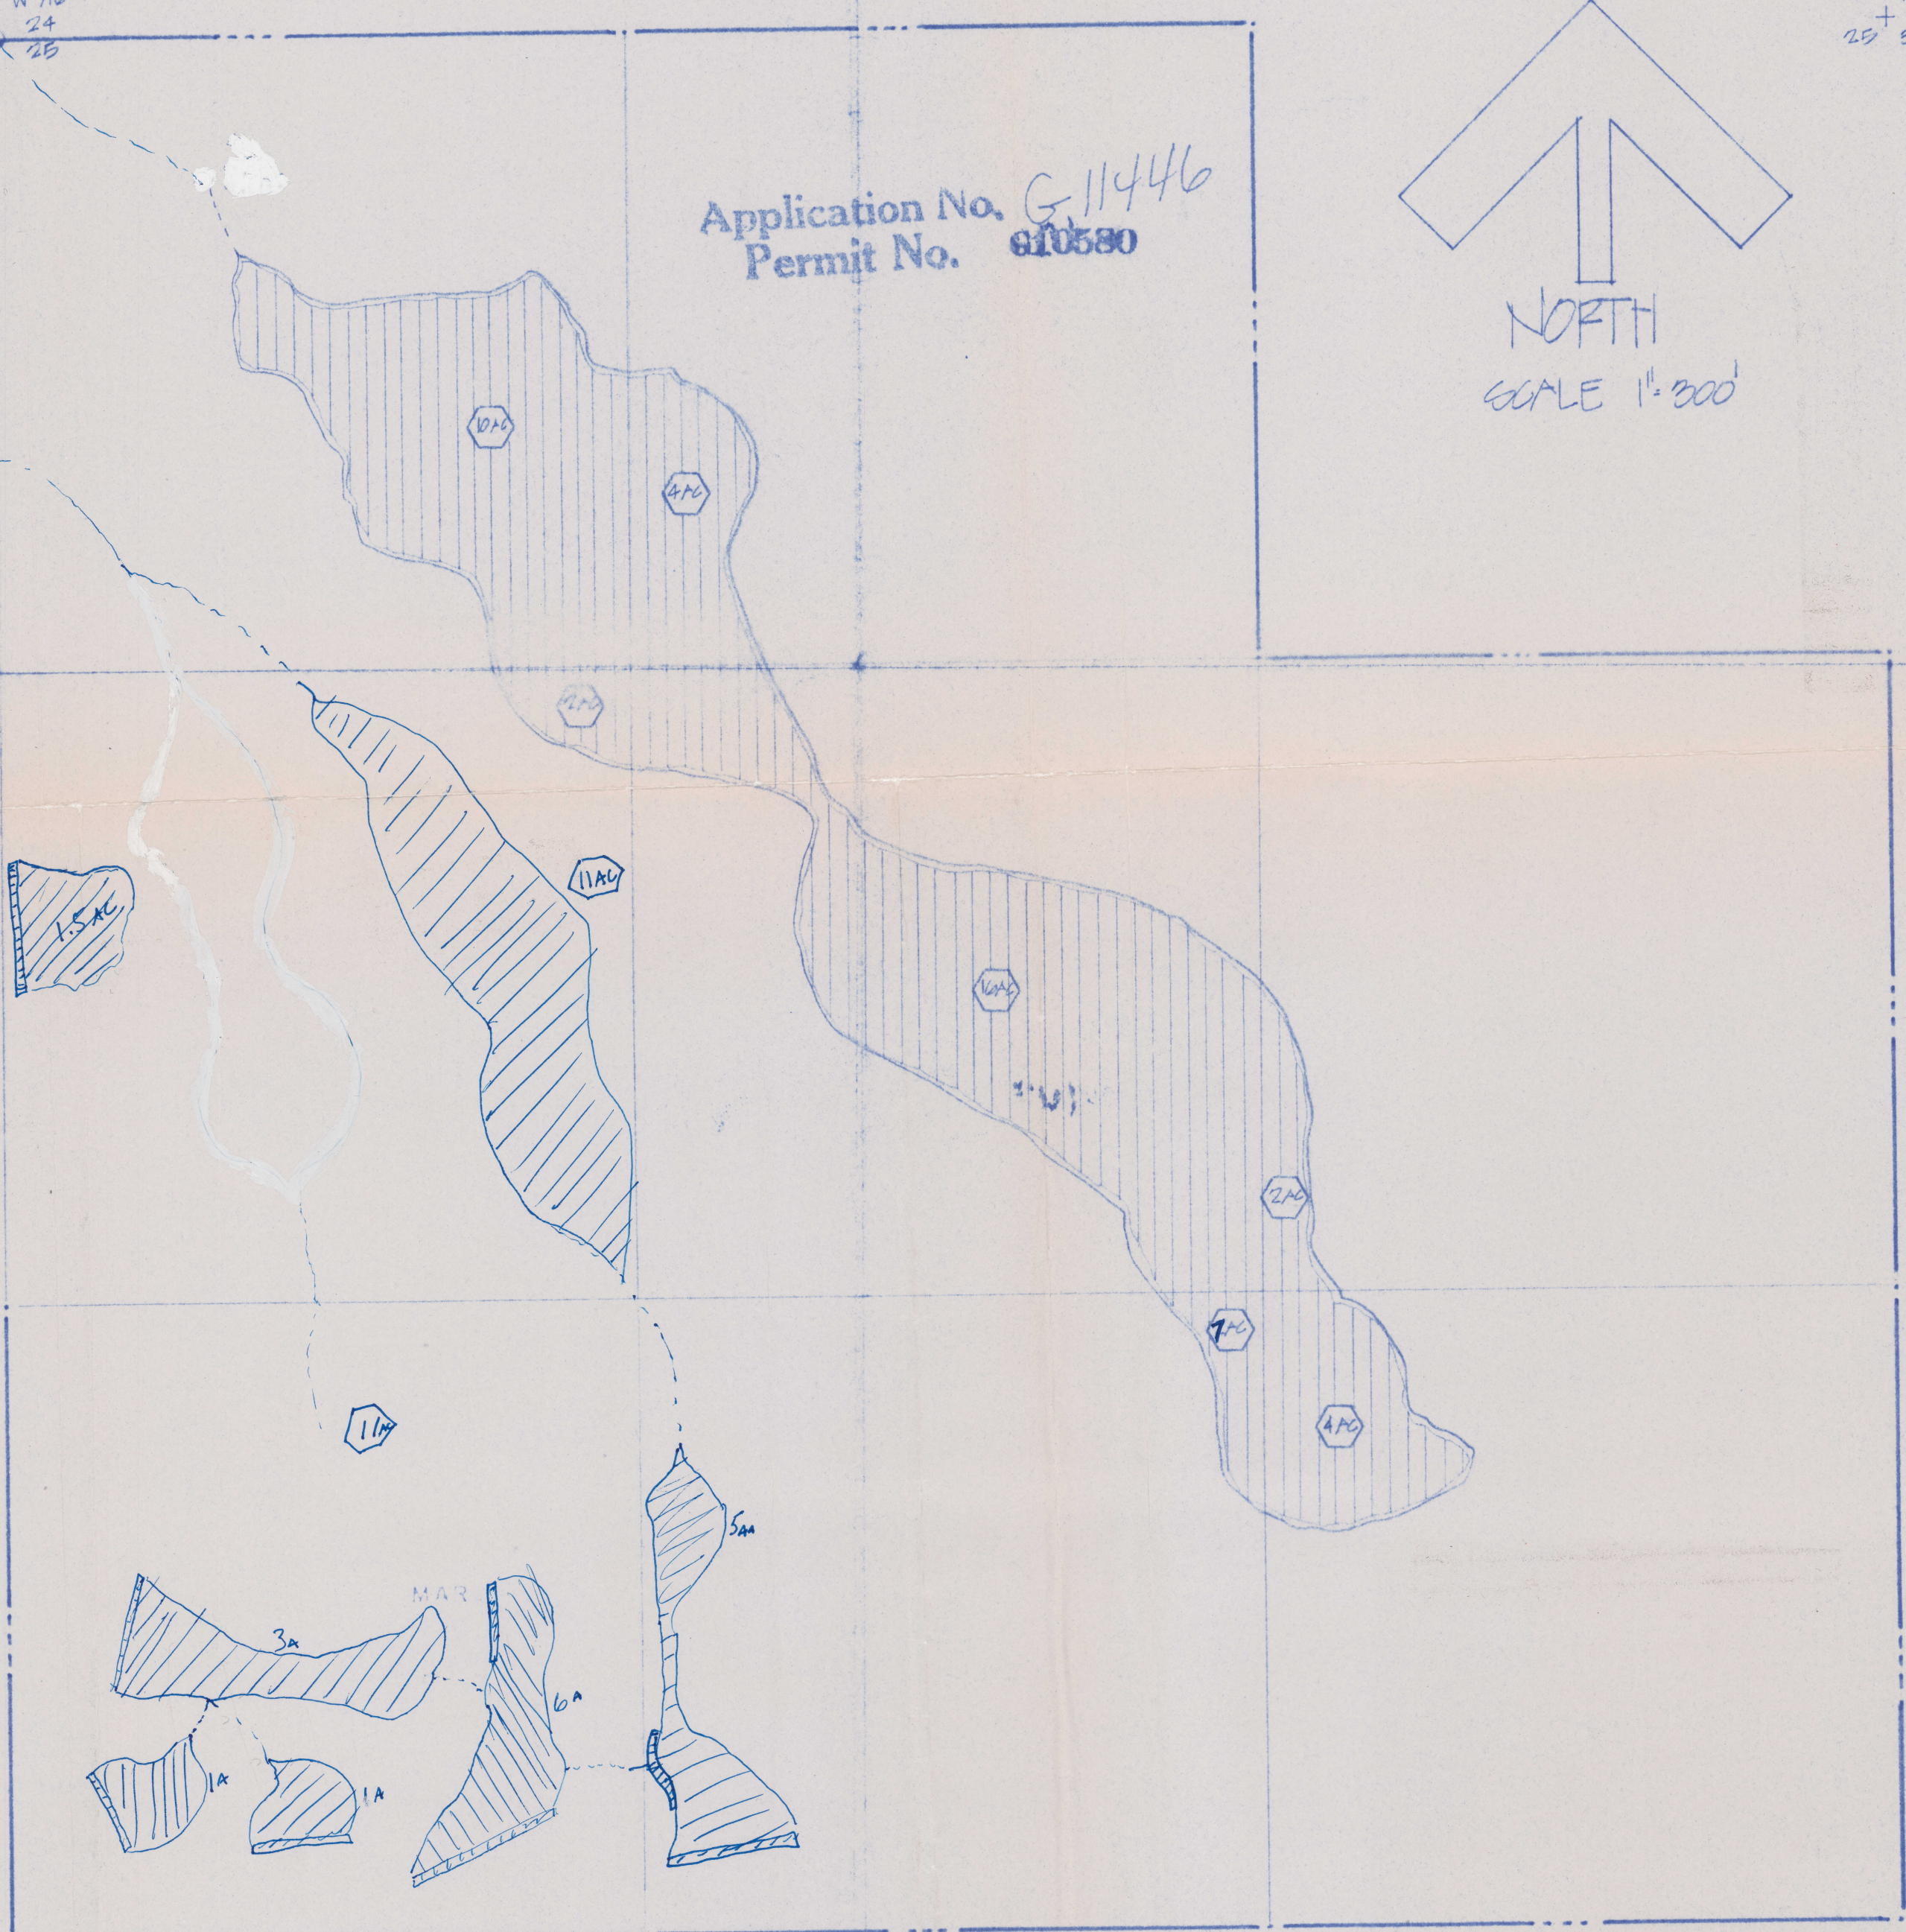

Application No. G-11446
Permit No. G-10580

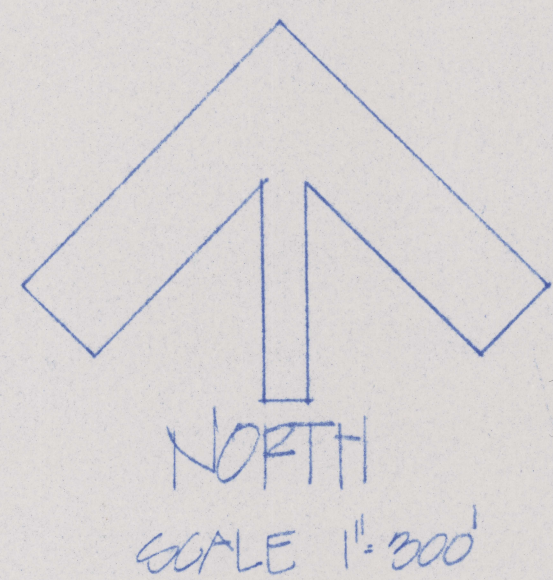

RECEIVED

SEP 24 1998

WATER RESOURCES DEPT.
SALEM, OREGON

480 ac.
(12 c 40 ac = 480 ac.)