

FINAL PROOF SURVEY

UNDER

APPL. NO. G-12541

PERMIT NO. G-11364


IN THE NAME OF MICHAEL & CAROLYN GRAHAM

SURVEYED JULY 31, 1995


T14S, R11E, W.M.



SCALE 1" = 1320'

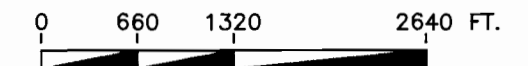


T14S

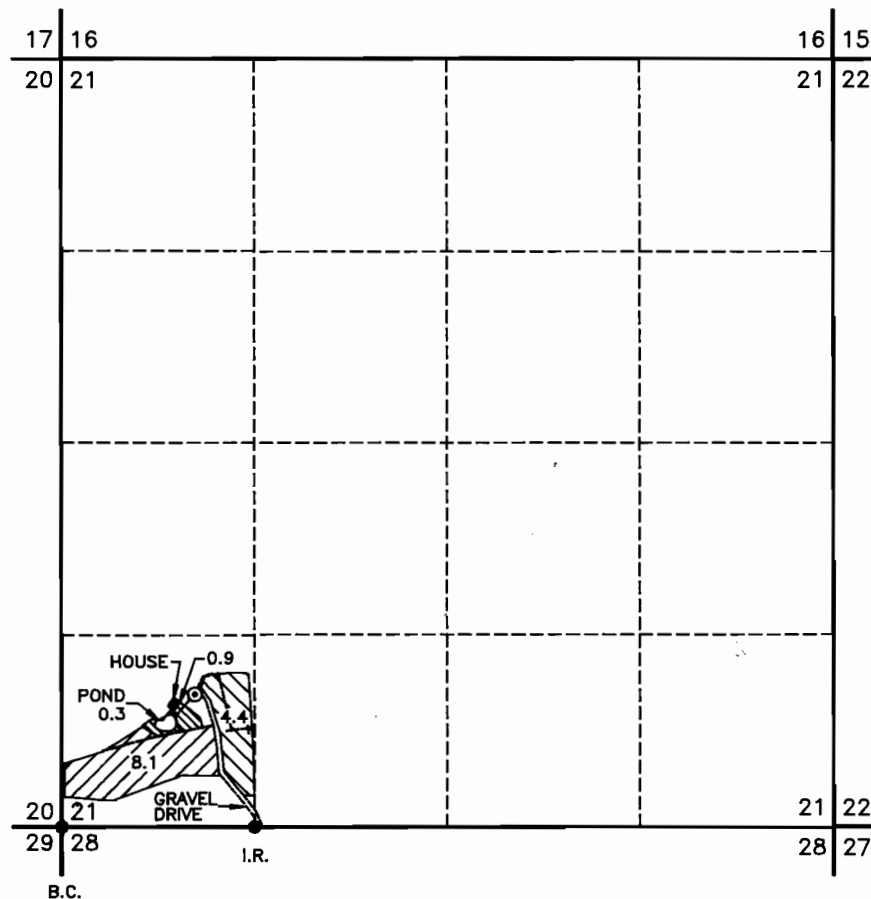

R11E

LEGEND

- SECTION LINE
- - - 1/4, 1/4 SECTION LINE
- EXISTING IRRIGATION MAINLINE
- ⊙ P.O.D - WELL AS NOTED. REFER TO NOTES FOR LOCATION.
- 8.1 AC. EXISTING IRRIGATED AREA FROM WELL AS PER PERMIT NO. G-11364 WITH CROPS
- 4.4 AC. EXISTING IRRIGATED AREA FROM WELL AS PER PERMIT NO. G-11364 WITH NO CROPS
- 0.9 AC. EXISTING IRRIGATED AREA FROM WELL AS PER PERMIT NO. G-11364 WITH GRASS LAWN

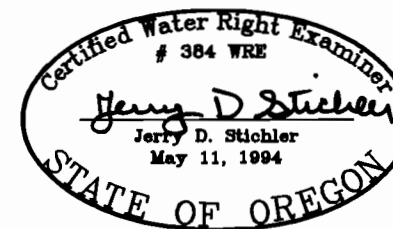

RENEWAL 6/30/96

NOTES

PREPARATION OF THIS MAP IS FOR PURPOSES OF IDENTIFYING PROPOSED WATER RIGHTS ONLY. IT HAS NO INTENT TO PROVIDE DIMENSIONS OR LOCATIONS OF PROPERTY BOUNDARIES.

WELL - POINT OF DIVERSION LOCATED 914' NORTH & 912' EAST FROM THE SW CORNER OF SECTION 21, T14S, R11E, W.M.

PREPARED FOR:
REED BROS. REALTY
360 W. CASCADE
SISTERS, OREGON 97759

PREPARED BY:
ANDERSON ENGINEERING & SURVEYING
539 SW 7TH STREET, P.O. BOX 419
REDMOND, OREGON 97756
(503) 923-4307 (503) 923-4308 FAX
JULY 31, 1995 SHEET 1 OF 1

DRAWN BY: J.S.	JOB NO. 95/53R
COGO: 9553FP	ACAD: 9553FP