

Township 18 South Range 3 West, W.M.


1/4 CORNER 17-18

NW 1/4 SW1/4 SEC. 16

RECEIVED

SEP 25 1998 *det*

WATER RESOURCES DEPT.
SALEM, OREGON

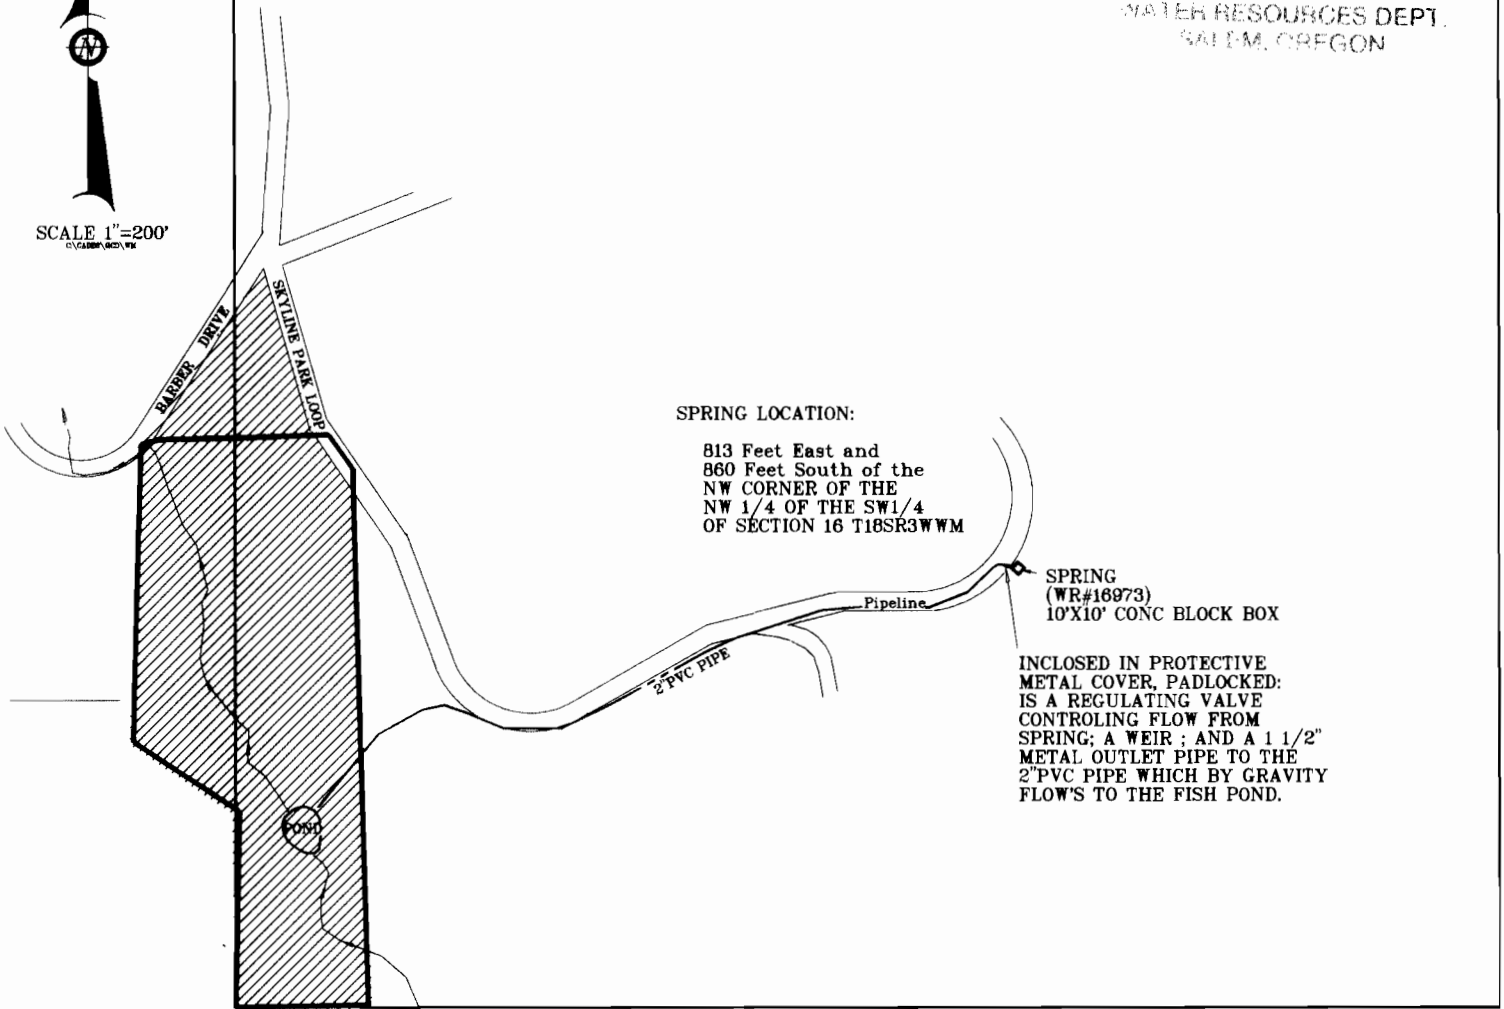

SPRING LOCATION:

813 Feet East and
860 Feet South of the
NW CORNER OF THE
NW 1/4 OF THE SW1/4
OF SECTION 16 T18SR3WWM

SPRING
(WR#16973)
10'X10' CONC BLOCK BOX

INCLUDED IN PROTECTIVE
METAL COVER, PADLOCKED:
IS A REGULATING VALVE
CONTROLLING FLOW FROM
SPRING; A WEIR ; AND A 1 1/2"
METAL OUTLET PIPE TO THE

FINAL PROOF SURVEY under Appl. No. 69655, Per. No. 51524

COMPLETED October 1, 1998



THIS MAP WAS PREPARED FOR THE PURPOSE OF
IDENTIFYING THE LOCATION OF A WATER RIGHT
ONLY AND IS NOT INTENDED TO PROVIDE LEGAL
DIMENSIONS OR LOCATION OF PROPERTY
OWNERSHIP LINES.