


Tax Lot No. TL600 23 12 20BC
Section 20 Township 23S Range 12W W.M.
Coos County

RECEIVED

NOV 20 1997

WATER RESOURCES DEPT
SALEM, OREGON

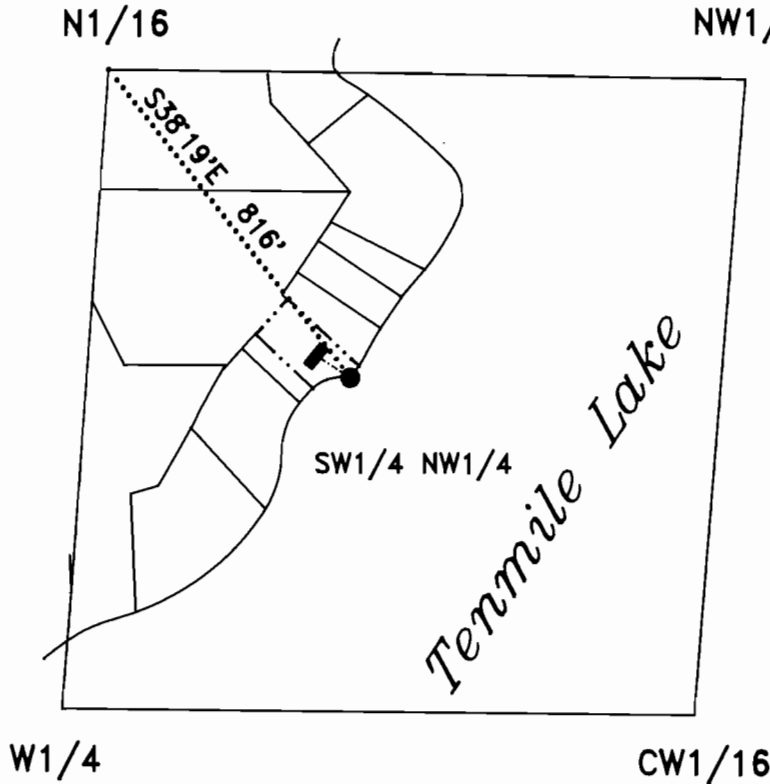


Legend

- P.O.D.
- · — · — Property Line
- Waterline
- House

EXAMINERS DISCLAIMER STATEMENT

The preparation of this map was for the purpose of identifying the location of the Water Right only and has no intent to provide dimensions or location of property ownership lines.

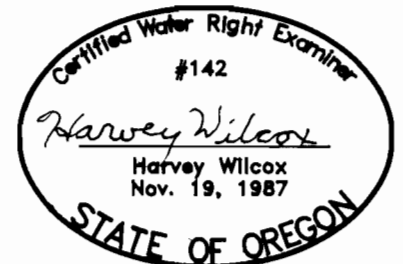

RENEWAL 6/30/98

FINAL PROOF SURVEY
IN THE NAME OF
Earl S. Epps

Surveyed on 9/2/97 by H.A. Wilcox

Application No. S-81106
Permit No. 53074