


T. 14S., R. 9E., W.M.

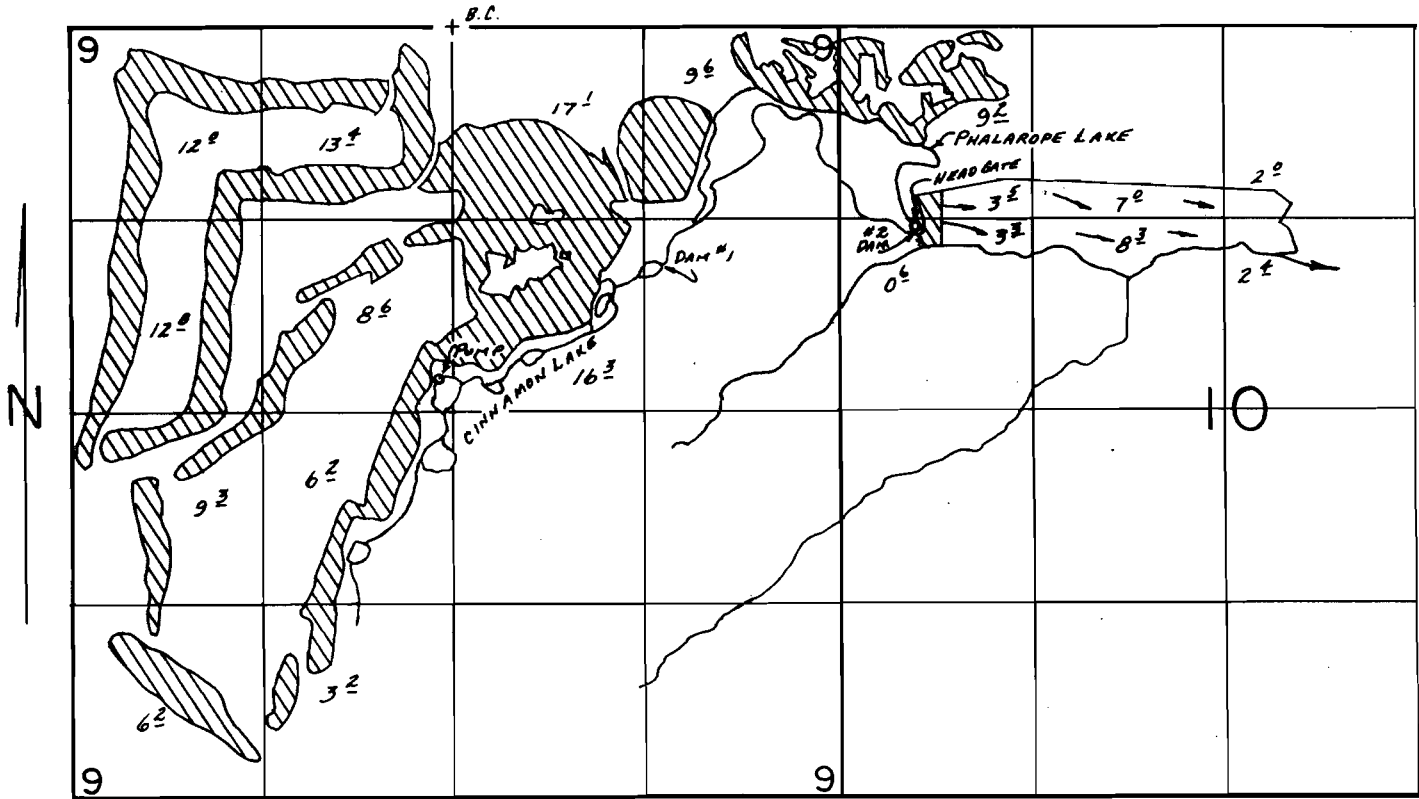

DIV. PTS. LOC: *1-1640'S. & 1430'E.; *2-1400'S. & 3150'E.; BOTH FROM N 1/4 COR. SEC. 9.

SCALE: 1" = 1320'

FINAL PROOF SURVEY
UNDER

R-53360 R-7836
Application No. 57980.. Permit No. 44270.....
IN NAME OF

BLACK BUTTE RANCH ASSOCIATION

Surveyed Mar. 21..... 1980, by L.H. NUNN.....
July 27 1988 B.W. BISHOP

12/2/88
B.R. PHOTOS BUB
41017-279-173L