


T. 14S., R. 9E., W.M.

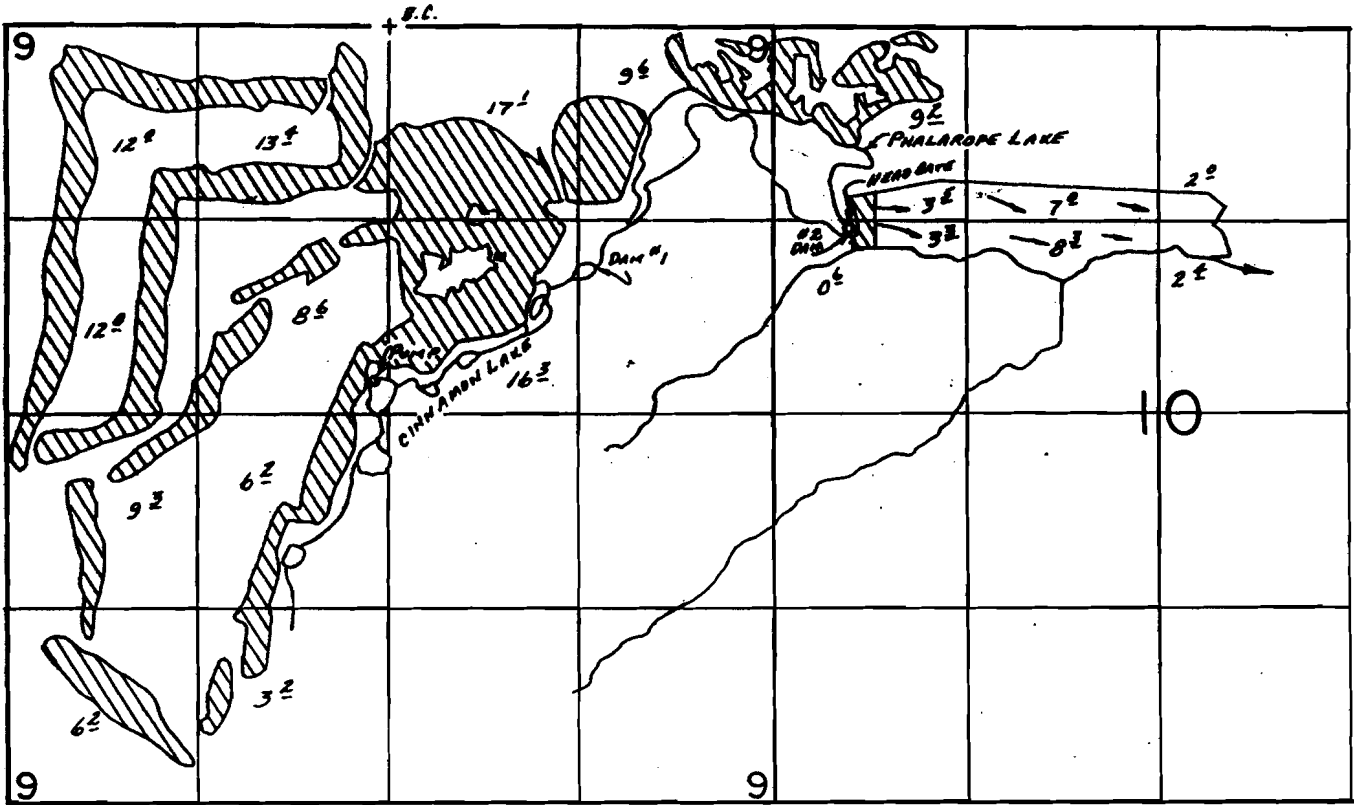

Div. Pts. Loc.: #1-1640'S. & 1430'E.; #2-1400'S. & 3150'E.; BOTH FROM N 1/4 COR. SEC. 9.

SCALE: 1" = 1320'

FINAL PROOF SURVEY
UNDER

R-53360 R-7836
Application No. 57980... Permit No. 44270... C-76004
IN NAME OF

BLACK BUTTE RANCH ASSOCIATION

Surveyed Mar. 21, 1980, by L.H. NUNN
July 27, 1988 B.W. BISHOP

12/2/88
B.R. Photos BalB
41017-279-173L

44270