


T.14S, R.9E., W.M.

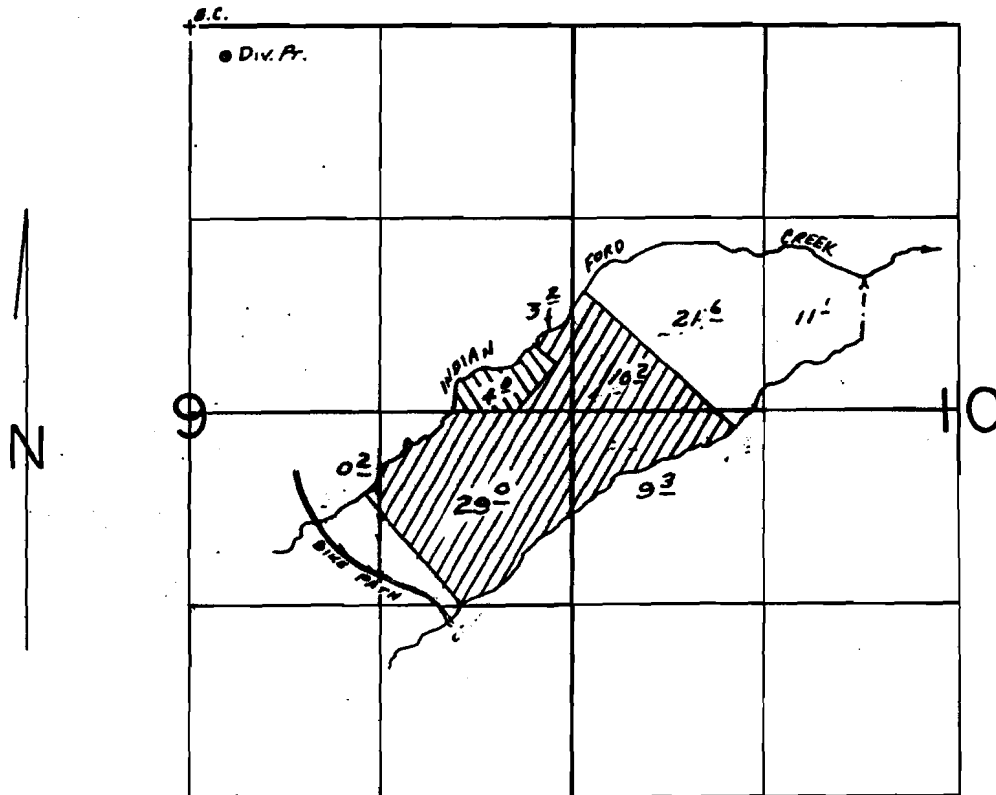

DIV. PT. LOC.: 200'S. & 240'E. FROM N. 1/4 COR. SEC. 9.

SCALE: 1" = 1320'

FINAL PROOF SURVEY
UNDER

Application No. 58296... Permit No. 44005.....
IN NAME OF

C-76005

BLACK BUTTE RANCH ASSOCIATION

Surveyed July 27... 1988, by B.W. BISHOP.....

Revised 2/2/99 *dep*
12/1/88
41017-279-173L *BWB*

44005