

Township 586 South, Range I West, W.M.

Portions of Sections 33 in Township 5 South and 4 in Township 6 South

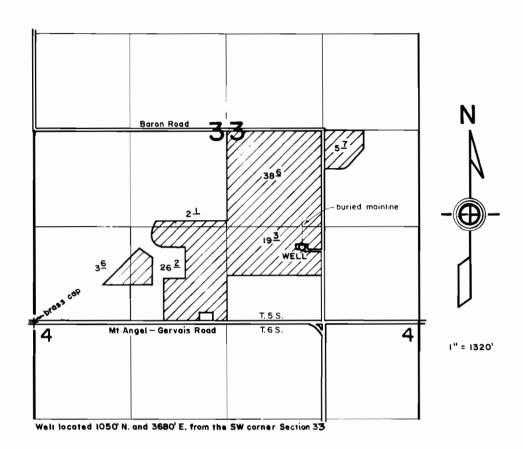

 




FINAL PROOF SURVEY under

Appl. No. G-12130, Per. No. G-11439 in name of

RON VANDECOEVERING

Jan. 23, 1996



THIS MAP WAS PREPARED FOR THE PURPOSE OF IDENTIFYING THE LOCATION OF A WATER RIGHT ONLY AND IS NOT INTENDED TO PROVIDE LEGAL DIMENSIONS OR LOCATION OF PROPERTY OWNERSHIP LINES.