


T.15S., R.46E., & R.47E., W.M.

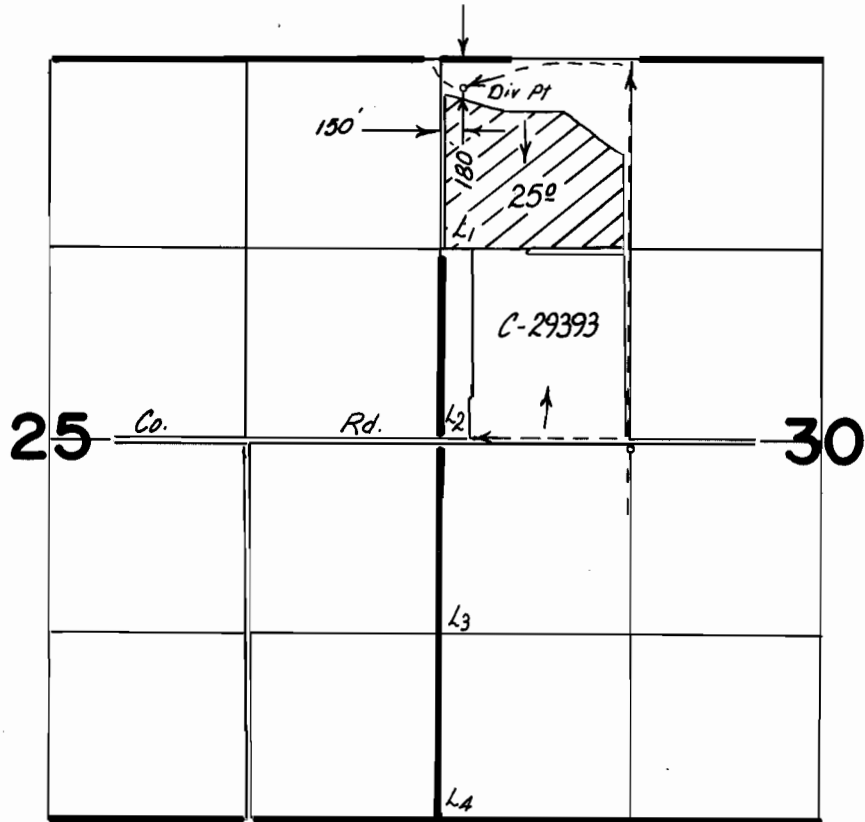

R.46E.
R.47E.

FINAL PROOF SURVEY UNDER

Application No. 61194 Permit No. 45528
IN NAME OF

GIBBS LAND & LIVESTOCK CO.

Surveyed 3-25 1986, by Larry Toll

Scale: 1" = 1320'