


T.15S., R.46E., & R.47E., W.M.

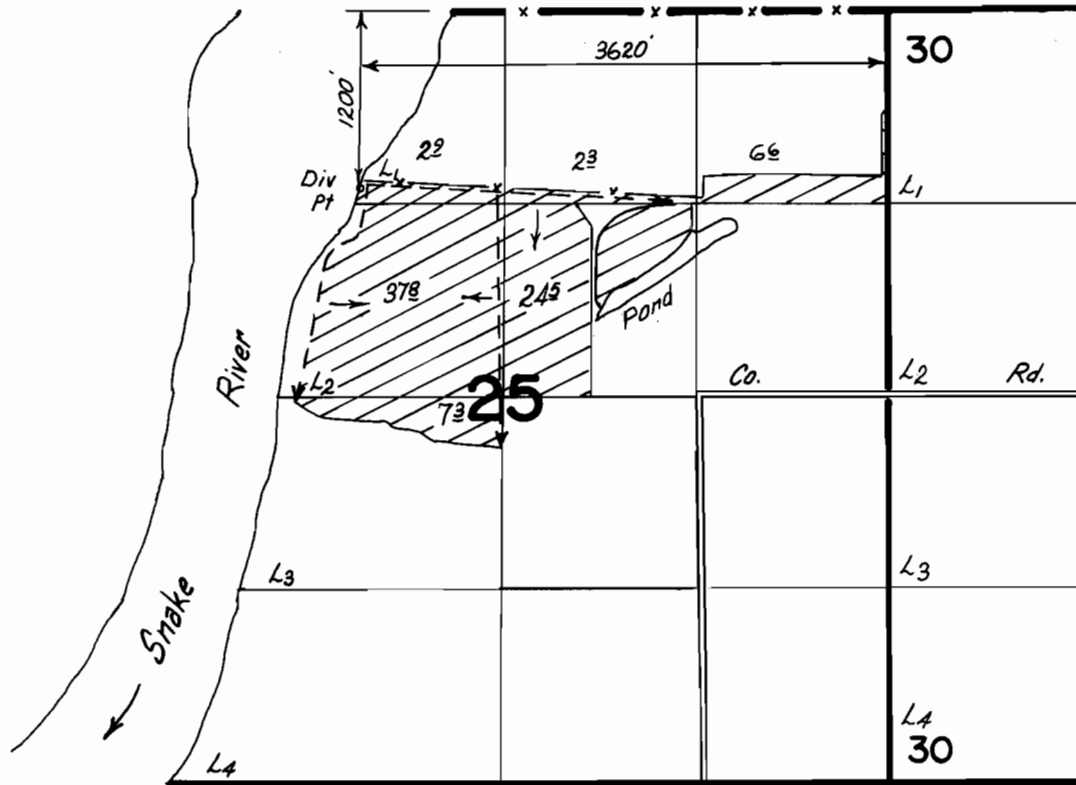

R.46E.
R.47E.

FINAL PROOF SURVEY UNDER

Application No. **61195**... Permit No. **45529**....
IN NAME OF

GIBBS LAND & LIVESTOCK CO......

Surveyed **3-25**..... 1986., by **Larry Toll**.....



Scale: 1" = 1320'