


T. 26S., R. 2 W., W. M.

Section 17

NE 1/4 SE 1/4

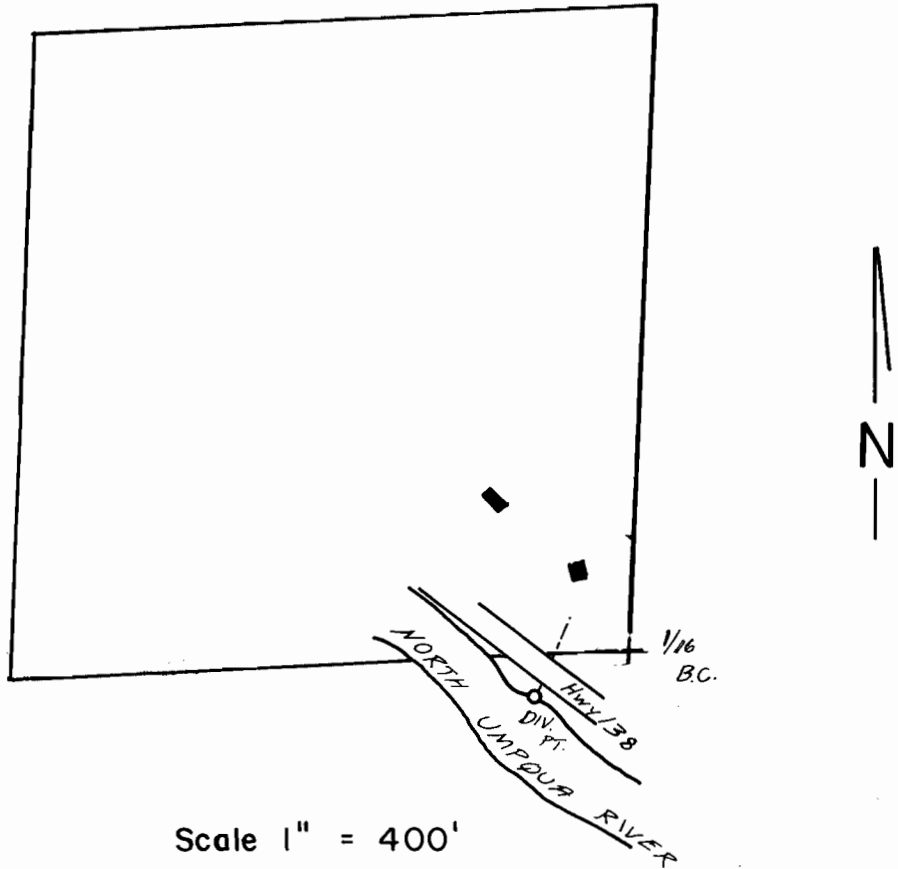

Scale 1" = 400'

DIV. PT.: 80' South & 200' West of E. S.E. Cor.

FINAL PROOF SURVEY

UNDER

Application No. 68363 Permit No. 49472.
IN NAME OF

RONALD J. and SHERRY A. MURPHY

Surveyed JULY 11, 1995, by S. DeHaas.....