


T.6&7S.R.2E.W.M.

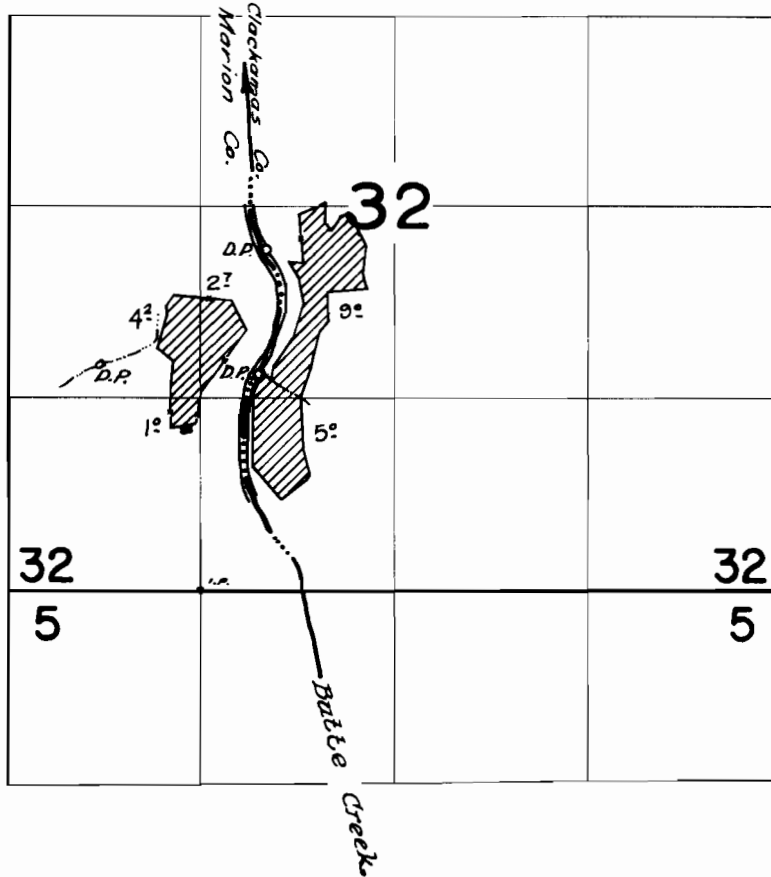

FINAL PROOF SURVEY

UNDER

Application No. **28478**... Permit No. **22303**...
IN NAME OF

Alfred & Eileen St. Clair—J. E. & Vivian St. Clair

Surveyed May 16, 1962, by R. Jackson

1962-K