


T. 13 S., R. 17 E., W. M.

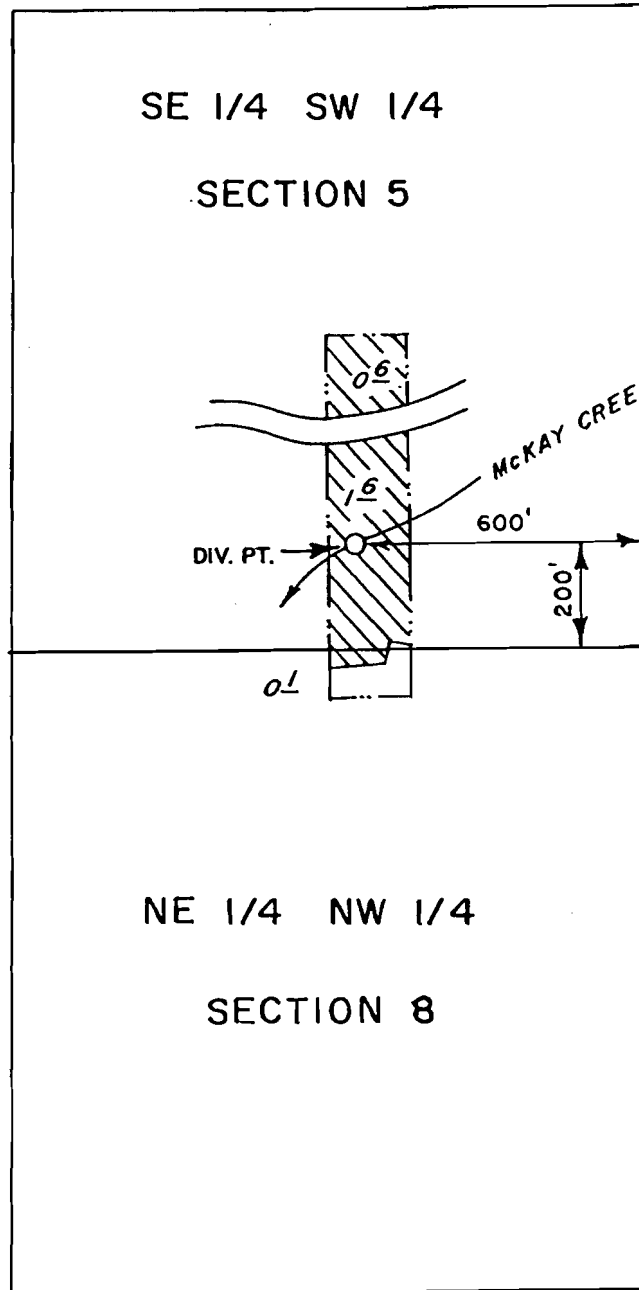

SCALE 1" = 400'

**FINAL PROOF SURVEY**  
UNDER

Application No. 60242 Permit No. 45561  
IN NAME OF

JOSEPH EDMONDS

Surveyed NOV. 12., 19.98., by STEVE BROWN

C 76017  
T 8642

4/5561