




LED NOS
200
201
thru
206

CROOK
1317

71778-76018 SCALE 1:48000

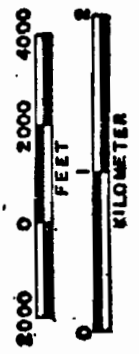

Application No. R-80046
Permit No. 6

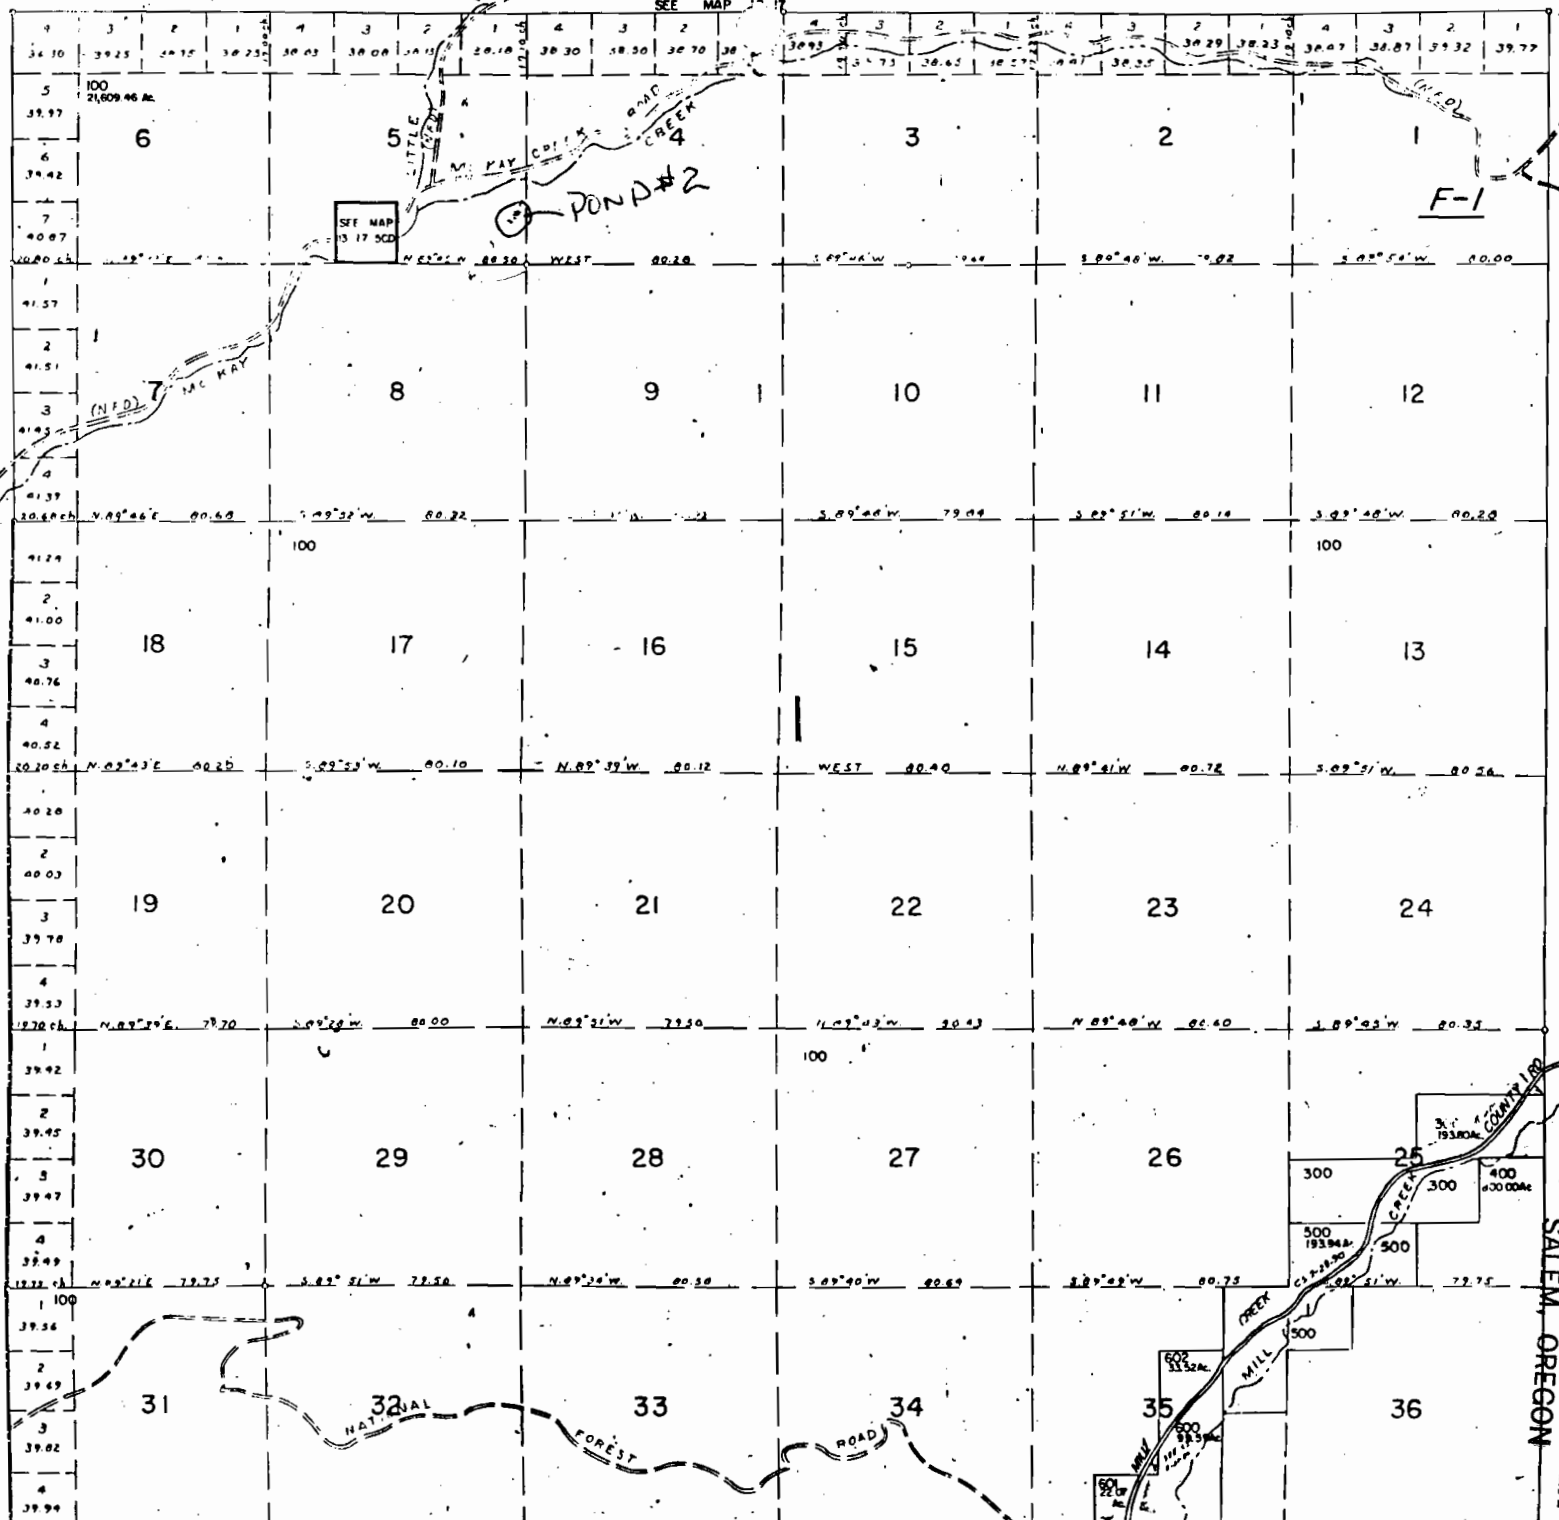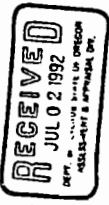

SEE MAP 13 18

WATER RESOURCES DEPT.
SALEM, OREGON

JAN - 4 1995

RECEIVED



THIS MAP WAS PREPARED FOR
ASSESSMENT PURPOSE ONLY

SE1/4 SW1/4 SEC. 5 T.13S. R.17E. W.M.
CROOK COUNTY
1" = 100'

13 11 300

CANCELLED NO.'S
401

SCALE 1:2400

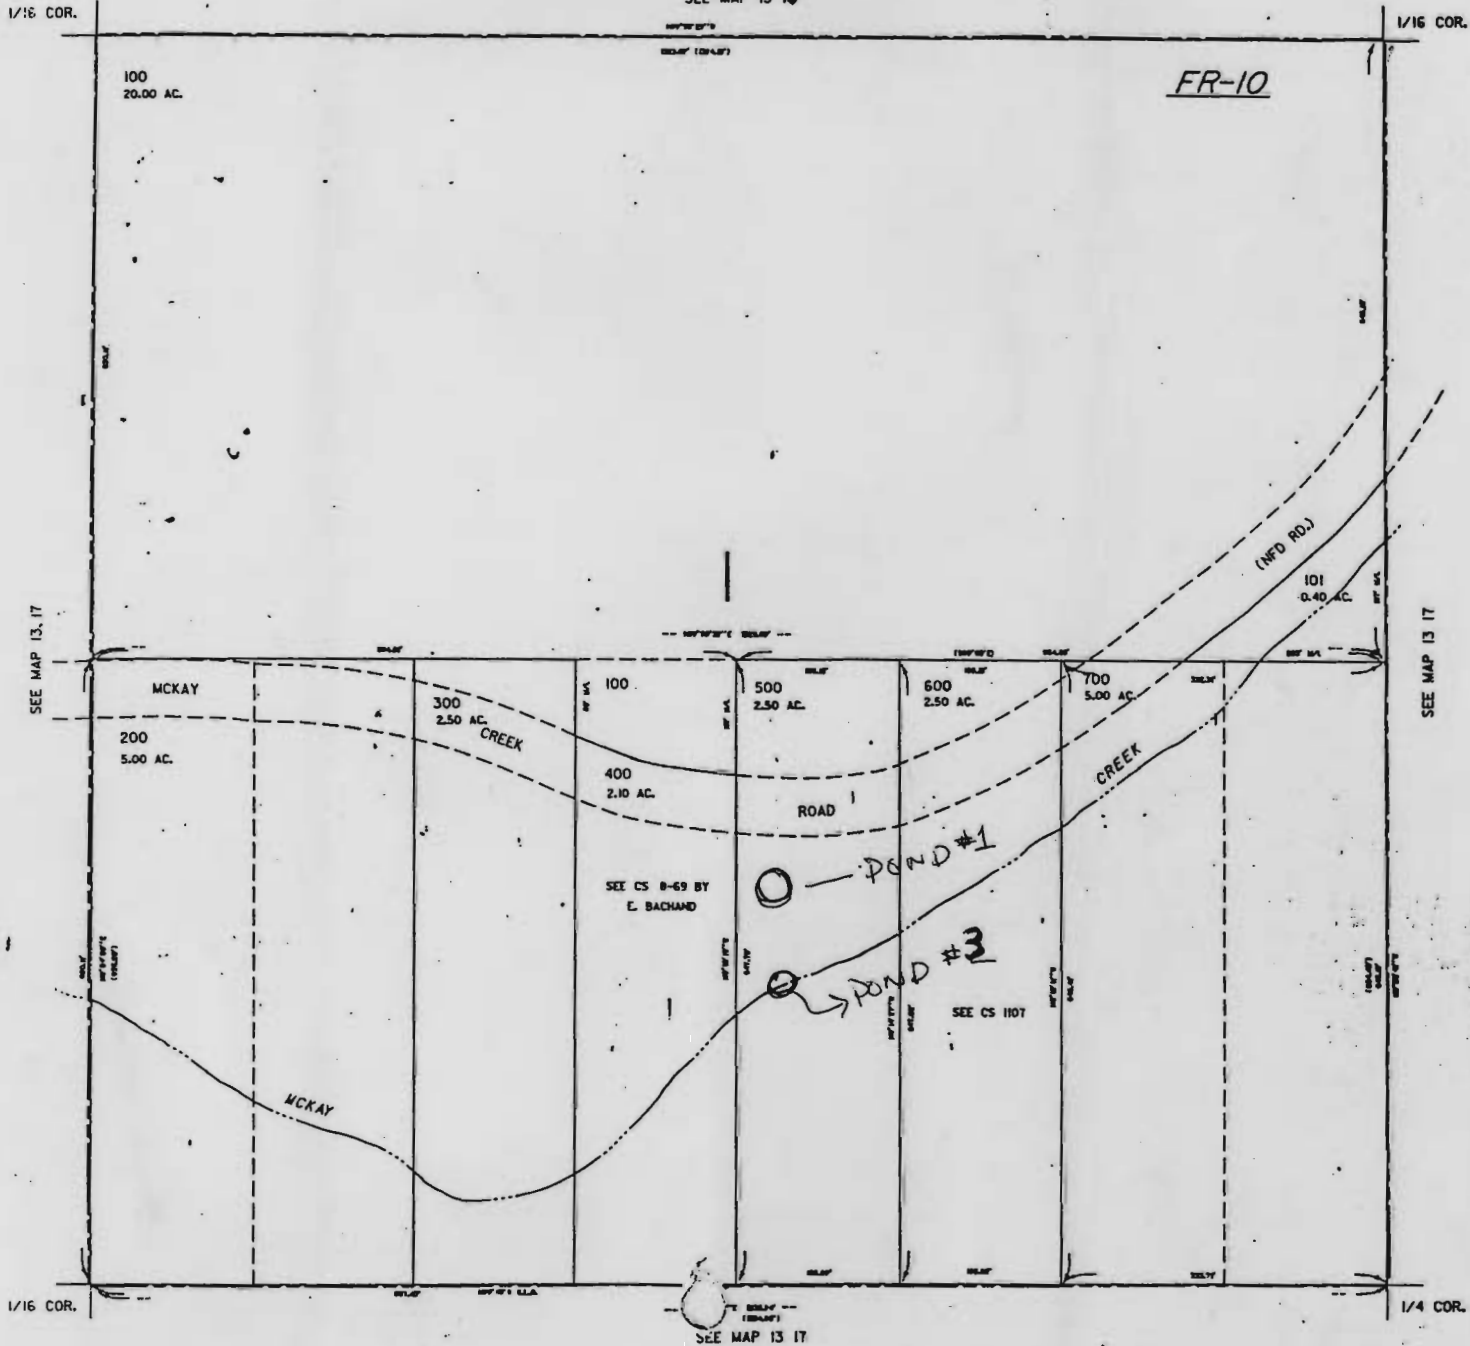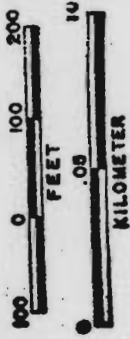

76018
71778
Application No. R-80096
Permit No.

WATER RESOURCES DEPT.
SALEM, OREGON

JAN - 4 1995

RECEIVED