



T. 11S., R. 43E. W. M.

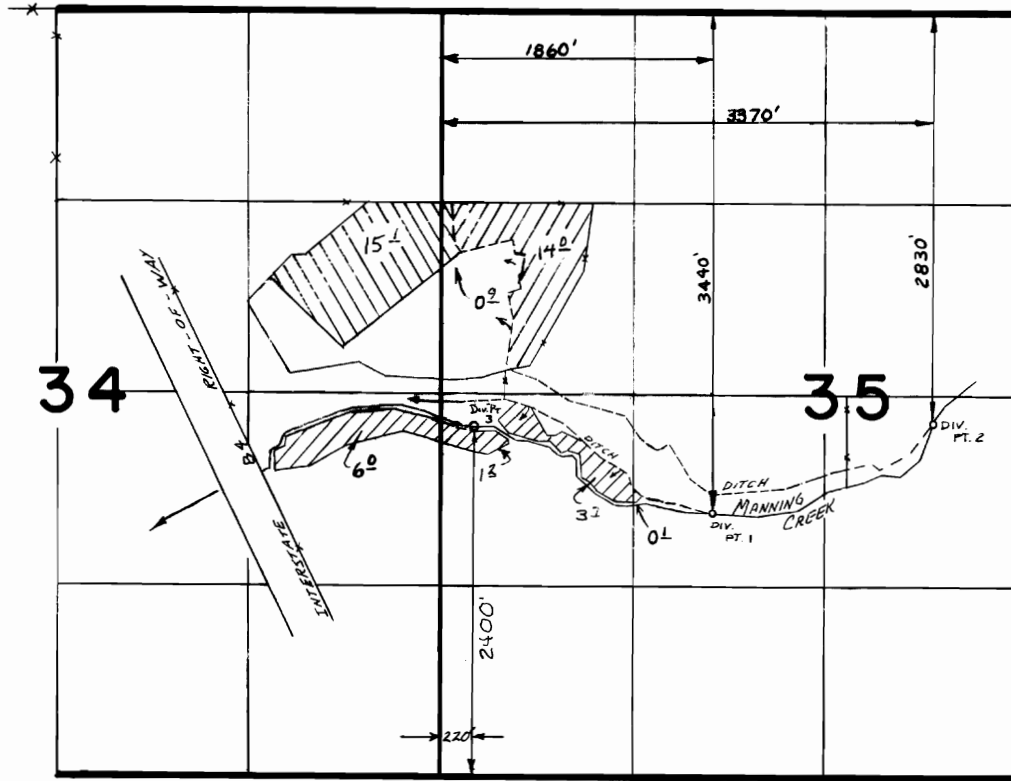

 T-3639

 PER. 42791  PER. 42790

FINAL PROOF SURVEY

UNDER

TRANSFER 3639

55749 42790

Application No. **55750** Permit No. **42791**

IN NAME OF

EDWIN AND BEVERLY WHITE

Surveyed 10-31 1978, by R. BARWIN
8-1 79 V. CHURCH & JARRETT
86 D. Clark

1967 W. FOR TEE (4000) 9/29/86 V.L.C.
PTS-1978-P-E 2/12/86 L.M.T.
PTS-1979-P-B V.L.C.

CORRECTIONS 2/12/86 L.M.T., 11/10/97 (K)

SCALE: 1" = 1320'

