


T. 1 S. R. 2 W. W. M.

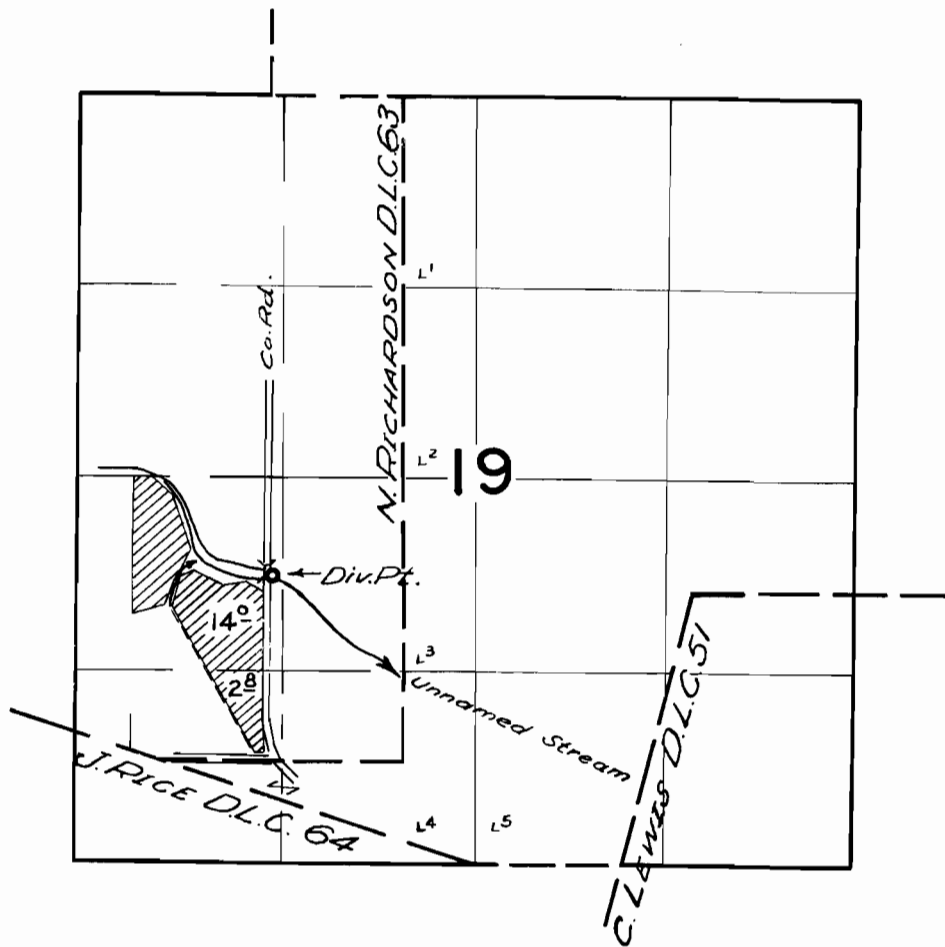

FINAL PROOF SURVEY UNDER

Application No. 37403 Permit No. 27858
IN NAME OF

RALPH A. WITHYCOMB

Surveyed Aug. 23, 1963, by *m. Bish*