T.6S. R.1W. W.M.

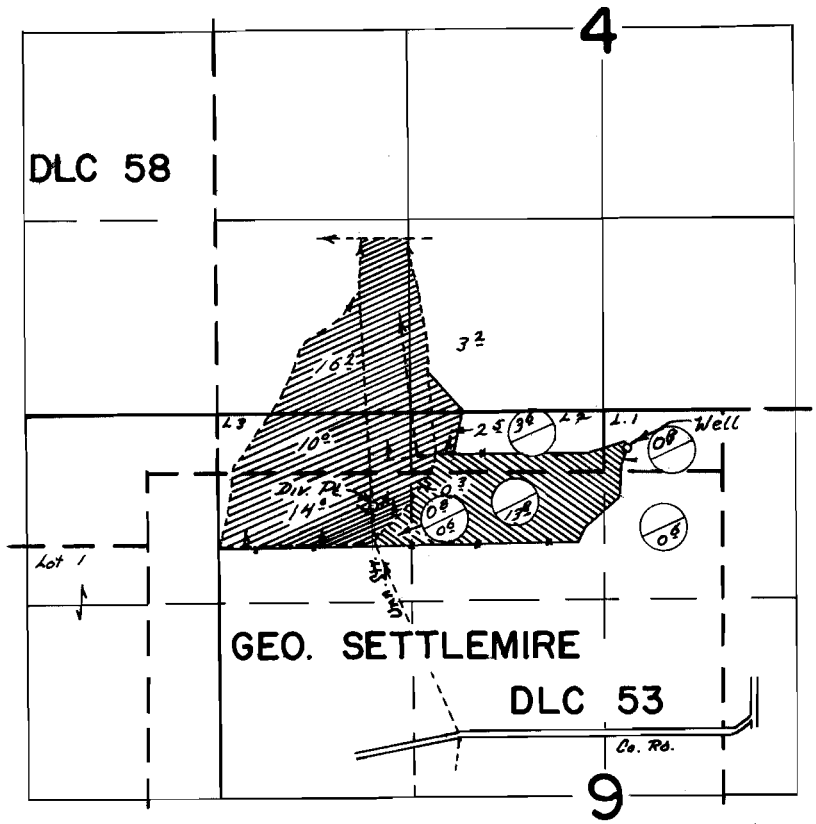

Well Loc: 250' S & 2820' E Unn Str. Div. Loc: 640' S & 1060' E
Both From NW Cor Sec 9.

G-4041
CR-1050'

FINAL PROOF SURVEY
UNDER

Application No. G-4041 43975 Permit No. G-3788 32851
IN NAME OF

RUEF FUR RANCH

Surveyed July 6 19 72, by R. G. Mucken

1972-2