


T.6 S. R. 1 W. W. M.

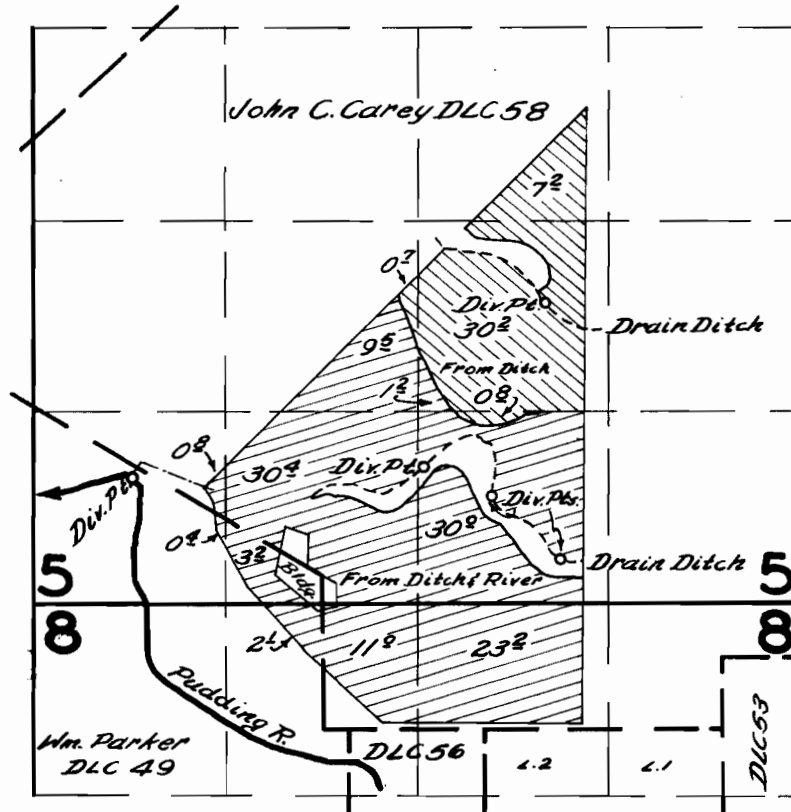

FINAL PROOF SURVEY UNDER

Application No. 25765 Permit No. 20271
IN NAME OF

JOHN FITZSIMMONS

Surveyed *Mar 21 1957* by *C. O. Bostelo*