


T.5N.R.27E.W.M.

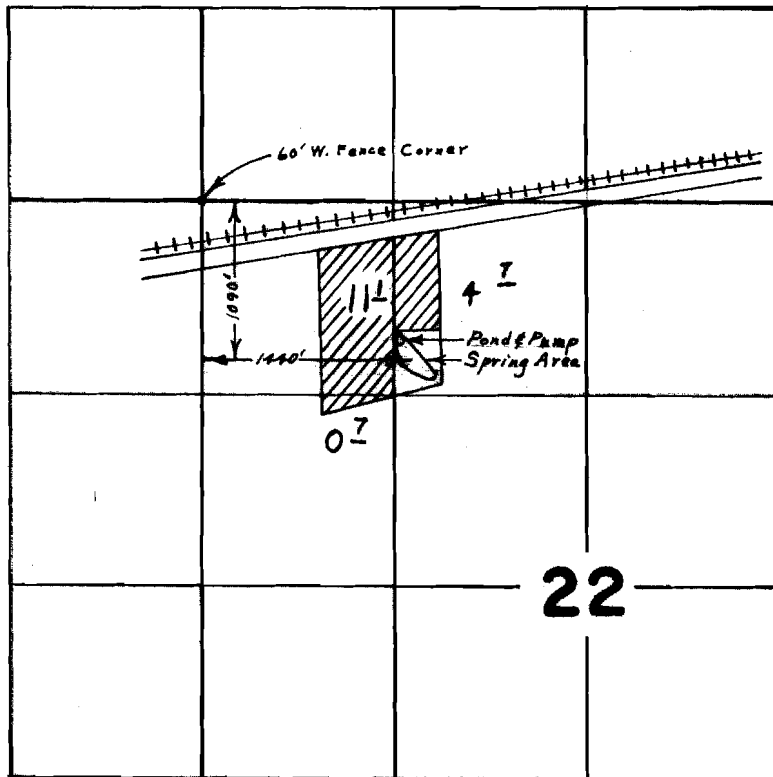

FINAL PROOF SURVEY UNDER

Application No. 37504 Permit No. 28356
IN NAME OF

JOHN CHILTON

Surveyed Aug. 10, 1966, by L. E. Gould