


T.1N., R.2W., W.M.

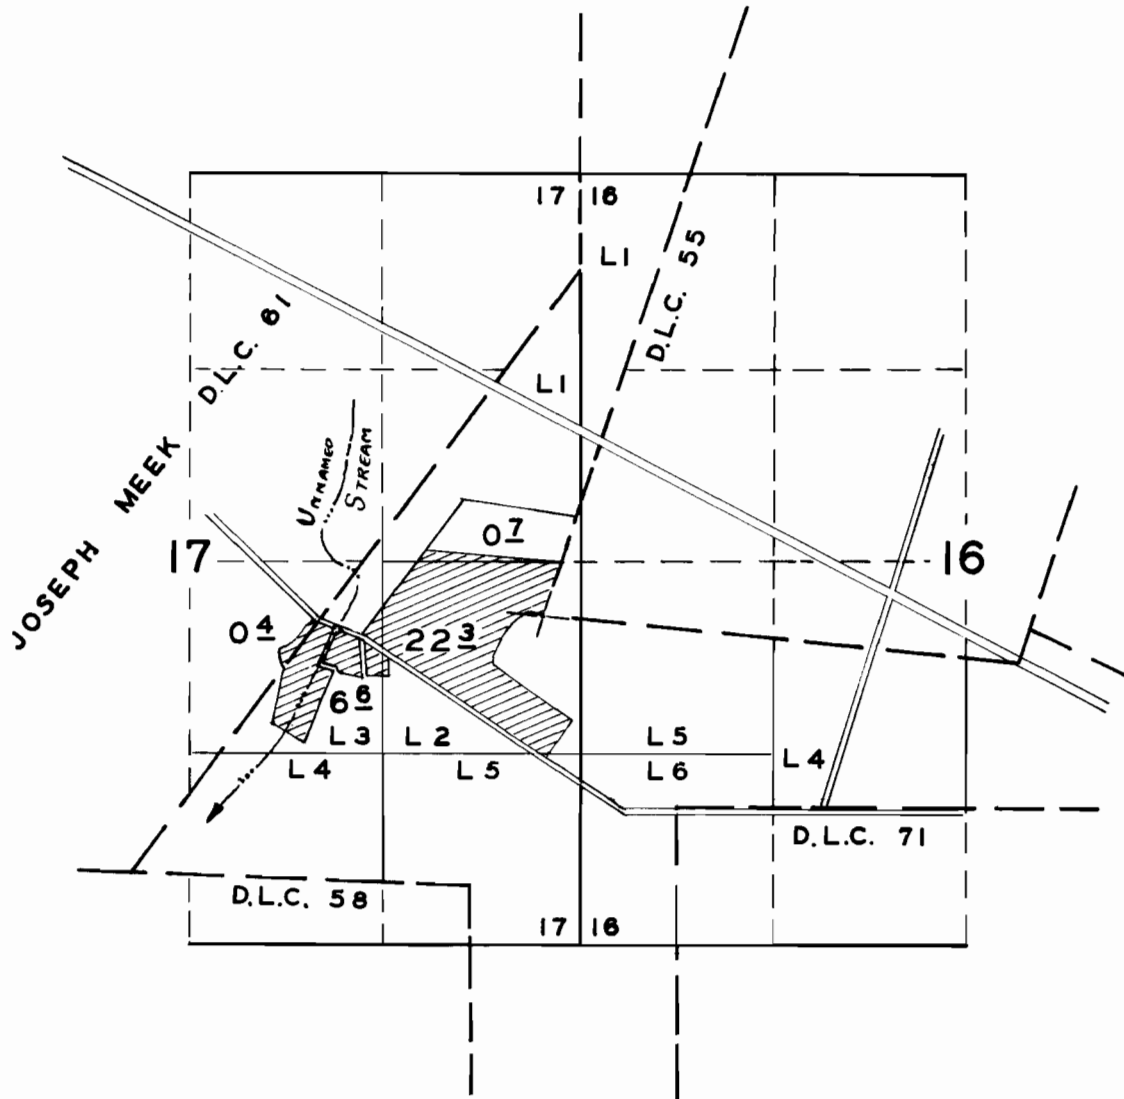

FINAL PROOF SURVEY

UNDER

Application No. 26820 Permit No. 21062

IN NAME OF

KAUER BROTHERS

Surveyed 4 - 11. 1956, by M. BISH